

STATE ENGINEER
Salem, Oregon

JACK
35060

Well Record

STATE WELL NO 38/1W-15L(1)
COUNTY Jackson
APPLICATION NO.

OWNER: City of Phoenix

MAILING ADDRESS:

LOCATION OF WELL: Owner's No. 1

CITY AND STATE:

NE 1/4 SW 1/4 Sec. 15 T. 38 N. S, R. 1 E. W., W.M.


Bearing and distance from section or subdivision corner 925' E. & 200' S. from E 1/4 cor. Sec. 16

1/8 mile SE of Phoenix

Altitude at well 1500'

TYPE OF WELL: Dr Date Constructed 1913

Depth drilled 700' Depth cased

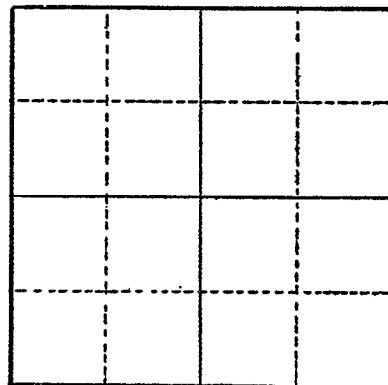

Section

CASING RECORD: SAID TO BE ±40' NOW (12-6-65)

8 inch

FINISH:

AQUIFERS:

WATER LEVEL:

PUMPING EQUIPMENT: Type Jet H.P. Capacity 275 G.P.M.

WELL TESTS: Drawdown ft. after hours G.P.M. Drawdown ft. after hours G.P.M.

USE OF WATER Municipal Temp. °F., 19

SOURCE OF INFORMATION Reg. Statement

DRILLER or DIGGER

ADDITIONAL DATA: Log Water Level Measurements Chemical Analysis Aquifer Test

REMARKS: