

STATE ENGINEER
Salem, Oregon

Sack
35063

Well Record

STATE WELL NO. *38/1W-15J(1)*
COUNTY *Jackson*
APPLICATION NO. *GR-133*

OWNER: *Andrew E. Stevens*


MAILING ADDRESS: *5055 Pacific Hwy. South*

LOCATION OF WELL: Owner's No. *1*

CITY AND STATE: *Medford, Oregon*

NE 1/4 *SE* 1/4 Sec. *15* T. *38* N. S., R. *1* W., W.M.

Bearing and distance from section or subdivision
corner *1491' N. & 1250' W. from SE cor. Sec. 15*

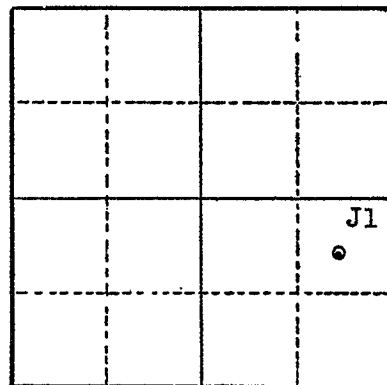

Section *15*

Altitude at well *1520' interpolated*

TYPE OF ~~WELL~~ ^{Sump}: *Dug* Date Constructed *1905*

Depth drilled *10* Depth cased

CASING RECORD:

Sump 800' x 8' wide x 3 to 10' deep

FINISH:

none open trench

AQUIFERS:

unknown

WATER LEVEL:

unknown

PUMPING EQUIPMENT: Type *Parma Water lift* H.P. *5*

Capacity *550* G.P.M.

WELL TESTS:

Drawdown ft. after hours G.P.M.

Drawdown ft. after hours G.P.M.

USE OF WATER *Irrigation 30 acres* Temp. °F., 19.....

SOURCE OF INFORMATION *Registration Statement GR-133*

DRILLER or DIGGER

ADDITIONAL DATA:

Log *No* Water Level Measurements Chemical Analysis Aquifer Test

REMARKS: