

STATE ENGINEER  
Salem, Oregon

579  
35064  
Well Record

STATE WELL NO. 38/1W-15R(1)  
COUNTY Jackson  
APPLICATION NO. GR-263

OWNER: Harry & David, Inc.


MAILING ADDRESS: 5277 S. Pacific Hwy

LOCATION OF WELL: Owner's No.

CITY AND STATE: Medford, Oregon

SE 1/4 SE 1/4 Sec. 15 T. 38 N. S., R. 1 E. W., W.M.

Bearing and distance from section or subdivision corner 30' N. & 50' W. of SE cor. Sec. 15

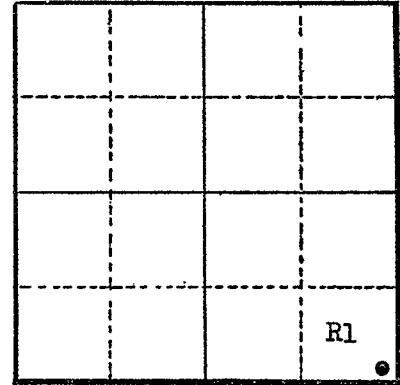

Section 15

Altitude at well ?

TYPE OF WELL: trench Date Constructed 1951

Depth drilled Depth cased

CASING RECORD:

FINISH:

AQUIFERS:

WATER LEVEL:

PUMPING EQUIPMENT: Type 2 Cornell centrifugal H.P. 2-15  
Capacity 400 G.P.M. each

WELL TESTS:

Drawdown ft. after hours G.P.M.  
Drawdown ft. after hours G.P.M.

USE OF WATER Irrigation Temp. °F., 19

SOURCE OF INFORMATION Registration Statement

DRILLER or DIGGER

ADDITIONAL DATA:

Log No Water Level Measurements Chemical Analysis Aquifer Test

REMARKS:

Infiltration trench 160' long, 40' wide 4 to 20' deep