

STATE ENGINEER
Salem, Oregon

JACK
35070

Well Record

STATE WELL NO. 38/1W-16J(1)
COUNTY _____
APPLICATION NO. _____

OWNER: City of Phoenix

MAILING
ADDRESS: _____

LOCATION OF WELL: Owner's No. #2

CITY AND
STATE: _____

..... 1/4 1/4 Sec. T. N. E.
S., R. W., W.M.


Bearing and distance from section or subdivision

corner _____

Altitude at well 1550'

TYPE OF WELL: Dr. Date Constructed 1915

Depth drilled 100 + Depth cased Deepened 1951

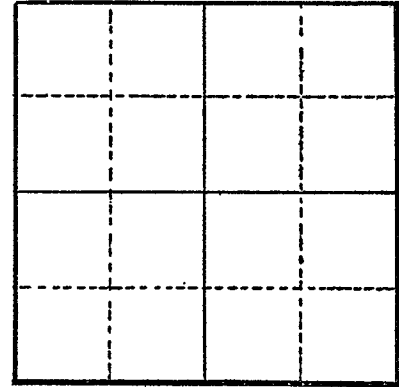

Section 16

CASING RECORD:

48" St. culvert 0 to 15'
8" St 0 to 30'

FINISH:

AQUIFERS:

WATER LEVEL:

PUMPING EQUIPMENT: Type Jacuzzi turbine 4 stage H.P. 5
Capacity 200 G.P.M.

WELL TESTS:

Drawdown ft. after hours G.P.M.
Drawdown ft. after hours G.P.M.

USE OF WATER Temp. °F., 19.....

SOURCE OF INFORMATION

DRILLER or DIGGER N. K. Lady

ADDITIONAL DATA:

Log Water Level Measurements Chemical Analysis Aquifer Test

REMARKS: