

STATE ENGINEER  
Salem, Oregon

JACK  
35071  
Well Record

STATE WELL NO. 38/1W - 160  
COUNTY JACKSON  
APPLICATION NO. GR-2127

OWNER: Dean Chapman


MAILING ADDRESS: 4334 Hilsinger Road

LOCATION OF WELL: Owner's No.

CITY AND STATE: Medford, Oregon

NE  $\frac{1}{4}$  SW  $\frac{1}{4}$  SE  $\frac{1}{4}$  Sec. 16 T. 38 N. S., R. 1 E. W., W.M.

Bearing and distance from section or subdivision corner 694' N. and 273' E.

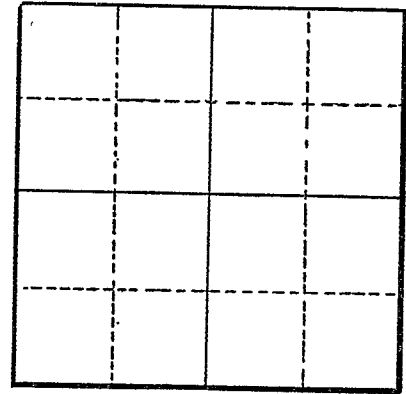

Section

Altitude at well

TYPE OF WELL: Dug Date Constructed 1954

Depth drilled 26 Depth cased 26

CASING RECORD:

30-Inch

FINISH:

AQUIFERS:

WATER LEVEL:

4-feet

PUMPING EQUIPMENT: Type Centrifugal pump H.P. 1.5  
Capacity 30 G.P.M.

WELL TESTS:

Drawdown ft. after hours G.P.M.  
Drawdown ft. after hours G.P.M.

USE OF WATER Irrigation Temp. °F. 19

SOURCE OF INFORMATION GR-2042

DRILLER or DIGGER

ADDITIONAL DATA:

Log Water Level Measurements Chemical Analysis Aquifer Test

REMARKS: