

STATE ENGINEER
Salem, Oregon

JACK Well Record
35672

STATE WELL NO. 38/W - 160
COUNTY JACKSON
APPLICATION NO. GR-2126

OWNER: A. J. Chapman


MAILING ADDRESS: 4335 Hilsinger Road

LOCATION OF WELL: Owner's No.

CITY AND STATE: Medford, Oregon

NE 1/4 SW 1/4 SE 1/4 Sec. 16 T. 38 N. S., R. 16 W., W.M.

Bearing and distance from section or subdivision corner 684' N. and 498' E.

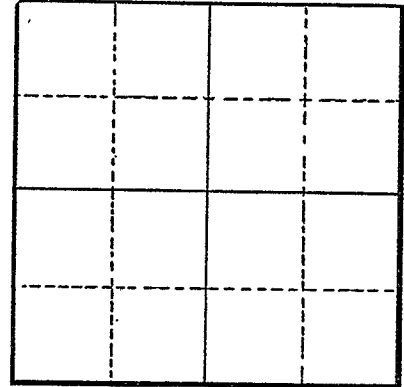

Section

Altitude at well

TYPE OF WELL: Dug Date Constructed 1932

Depth drilled 36 Depth cased 18 36

CASING RECORD:

36-inch

FINISH:

AQUIFERS:

WATER LEVEL:

4.0-feet

PUMPING EQUIPMENT: Type Centrifugal (Deming) H.P. 2
Capacity 110 G.P.M.

WELL TESTS:

Drawdown No ft. after hours Pumping 110 G.P.M.
Drawdown ft. after hours G.P.M.

USE OF WATER Irrigation Temp. °F. 19

SOURCE OF INFORMATION GR-2041

DRILLER or DIGGER

ADDITIONAL DATA:

Log Water Level Measurements Chemical Analysis Aquifer Test

REMARKS: