

STATE ENGINEER
Salem, Oregon

JACK
35073

Well Record

GR- 1642

STATE WELL NO. 38/1W-160
COUNTY Jackson
APPLICATION NO. GR- 1692

OWNER: John E. Myers

MAILING ADDRESS:

4425 Hilsinger Rd.

LOCATION OF WELL: Owner's No.


CITY AND STATE:

Medford, Oregon

SW ^{XX} 1/4 SE ^{EX} 1/4 Sec. 16 T. 38 S., R. 1 W., W.M.

Bearing and distance from section or subdivision

corner 45' N. & 480' E. from SW cor. DIC #55

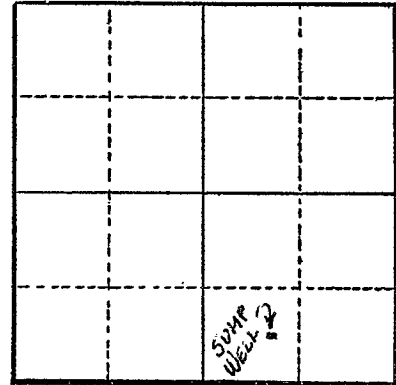

Section 16

Altitude at well 1580'

TYPE OF WELL: Dug Date Constructed 1953

Depth drilled 25' Depth cased 25'

CASING RECORD:

24" concrete tile from 13 to 25 ft.

FINISH:

Perforated: 1" x 1 1/4" (5/ft.) from 13 to 25 ft.

AQUIFERS:

WATER LEVEL:

13'

PUMPING EQUIPMENT: Type Jacuzzi 1 1/2" Cent. H.P. 2

Capacity 50 G.P.M.

WELL TESTS:

Drawdown 20 ft. after 50 hours G.P.M.

Drawdown ft. after hours G.P.M.

USE OF WATER Irrigation Temp. °F. 19

SOURCE OF INFORMATION GR Record

DRILLER or DIGGER Tru-Mix Construction Co.

ADDITIONAL DATA:

Log N.A. Water Level Measurements Chemical Analysis Aquifer Test

REMARKS:

This well was dug in center of a sump which is 16' x 3 1/2' x 9'

Irrigation of 15 acres.