

STATE ENGINEER  
Salem, Oregon

JACK  
35076 Well Record

STATE WELL NO. 38/lw-17Q  
COUNTY Jackson  
APPLICATION NO. GR-3359

OWNER: Evelyn I. Whitmore


MAILING ADDRESS: Route 4, Box 429-B-1

LOCATION OF WELL: Owner's No.

CITY AND STATE: Medford, Oregon

SW 1/4 SE 1/4 Sec. 17 T. 38 N. S., R. 1 W., W.M.

Bearing and distance from section or subdivision corner 445' N. and 355' E.

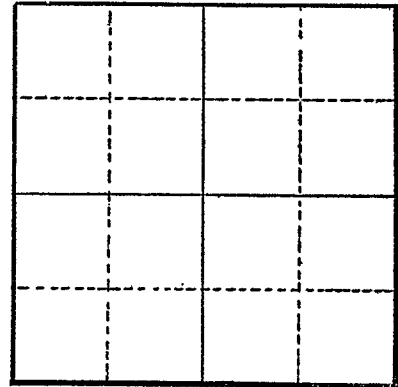

Section .....

Altitude at well .....

TYPE OF WELL: drilled Date Constructed 1951

Depth drilled 72' Depth cased 70'

CASING RECORD:

6"

FINISH:

AQUIFERS:

WATER LEVEL:

30'

PUMPING EQUIPMENT: Type 1.5" Centrifugal Jet Pump H.P. 2  
Capacity 50 G.P.M.

WELL TESTS:

Drawdown ..... ft. after ..... hours ..... G.P.M.  
Drawdown ..... ft. after ..... hours ..... G.P.M.

USE OF WATER Irrigation Temp. °F. ...., 19

SOURCE OF INFORMATION GR-3110

DRILLER or DIGGER Deister Well Drilling Co. Medford, Oregon

ADDITIONAL DATA:

Log ..... Water Level Measurements ..... Chemical Analysis ..... Aquifer Test .....

REMARKS: