

STATE ENGINEER
Salem, Oregon

Jack Well Record
35091 GR- 1780

STATE WELL NO. 38/2W-1L
COUNTY Jackson
APPLICATION NO. GR- 1835

OWNER: Robert P. Gates


MAILING ADDRESS: 1280 South Stage Rd.

LOCATION OF WELL: Owner's No.

CITY AND STATE: Medford, Oregon

NE 1/4 SW 1/4 Sec. 1 T. 38 N. R. 2 W., W.M.

Bearing and distance from section or subdivision corner 1478' S. & 291' E. from NE cor. D.L.C. #50

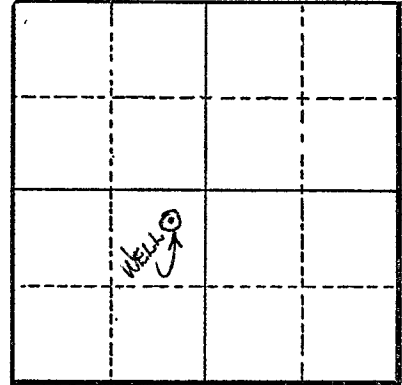

Section 1

Altitude at well Approx. 1500'

TYPE OF WELL: Drilled Date Constructed 1950

Depth drilled 100' Depth cased

CASING RECORD:
6"

FINISH:

AQUIFERS:

WATER LEVEL:

PUMPING EQUIPMENT: Type American 1 1/4 x 1 in. deep well jet H.P. 1/2
Capacity 10 G.P.M.

WELL TESTS:
Drawdown ft. after hours G.P.M.
Drawdown ft. after hours G.P.M.

USE OF WATER Irrigation Temp. °F. 19

SOURCE OF INFORMATION GR Record

DRILLER or DIGGER

ADDITIONAL DATA:
Log N.A. Water Level Measurements Chemical Analysis Aquifer Test

REMARKS:

Irrigation of 0.8 acres.