

STATE ENGINEER
Salem, Oregon

JACK
35232 Well Record

STATE WELL NO. 36/1W-8H
COUNTY JACKSON
APPLICATION NO. GR-2550

OWNER: G. E. OUSTERHOUT


MAILING ADDRESS: Rt 1 Box 676

LOCATION OF WELL: Owner's No. _____

CITY AND STATE: Eagle Point, Oregon

SE 1/4 NE 1/4 Sec. 8 T. 36 S., R. 1 W., W.M.

Bearing and distance from section or subdivision
corner 560' N & 1100' W from E 1/4 cor Sec 8

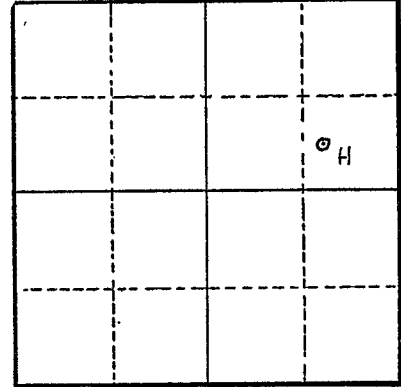

Section 8

Altitude at well _____

TYPE OF WELL: Drilled Date Constructed 1951

Depth drilled 150' Depth cased 12'

CASING RECORD:

6-inch

FINISH:

slotted

AQUIFERS:

shale

WATER LEVEL:

30'

PUMPING EQUIPMENT: Type Turbine H.P. 5

Capacity 80 G.P.M.

WELL TESTS:

Drawdown 100 ft. after _____ hours 75 G.P.M.

Drawdown _____ ft. after _____ hours _____ G.P.M.

USE OF WATER Irrigation Temp. _____ °F. _____, 19_____

SOURCE OF INFORMATION GR-3956

DRILLER or DIGGER Goff Bros

ADDITIONAL DATA:

Log x Water Level Measurements _____ Chemical Analysis _____ Aquifer Test _____

REMARKS:

Shale- some 30'
water at each 60'
90'