

STATE ENGINEER
Salem, Oregon

JACK
35314

Well Record

STATE WELL NO. 38/1W-19A(1)
COUNTY Jackson
APPLICATION NO. GR-172

OWNER: Lester Lee IG)

MAILING ADDRESS:


LOCATION OF WELL: Owner's No. 1

CITY AND STATE:

Medford, Oregon

NE 1/4 NE 1/4 Sec. 19 T. 38 S., R. 1 E. W., W.M.

Bearing and distance from section or subdivision corner 120' W. & 68' S. from NE cor. Sec. 19

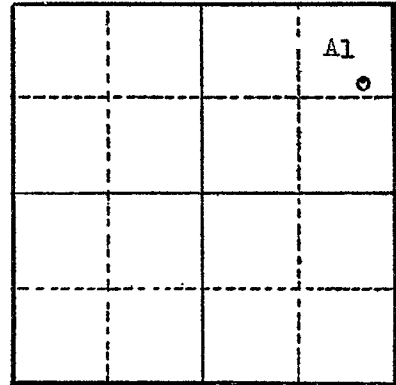

Section 19

Altitude at well 1800' Interpolated

TYPE OF WELL: Dug Date Constructed 6/1/51

Depth drilled Sump 15 Depth cased

CASING RECORD:

Sump 30' x 15' deep x ??

FINISH:

none

AQUIFERS:

no record

WATER LEVEL:

3 feet below land surface (June 1, 1952)

PUMPING EQUIPMENT: Type Jacuzzi centrifugal "2" H.P. 5
Capacity 250 G.P.M.

WELL TESTS:

Drawdown 4-5 ft. after hours pumping 250 G.P.M.
Drawdown ft. after hours G.P.M.

USE OF WATER Irrigation Temp. °F., 19

SOURCE OF INFORMATION Registration Statement GR-172

DRILLER or DIGGER

ADDITIONAL DATA:

Log No Water Level Measurements Chemical Analysis Aquifer Test

REMARKS: