

STATE ENGINEER
Salem, Oregon

JACK Well Record
35317 GR- 956

STATE WELL NO. ...38/1W-20D(1)
COUNTY ...Jackson
APPLICATION NO. ...GR-987

OWNER: Walter D. Nunley


MAILING ADDRESS: Rt. 1, Box 427-A

LOCATION OF WELL: Owner's No. _____

CITY AND STATE: Medford, Oregon

NW 1/4 NW 1/4 Sec. 20 T. 38 S. R. 1 W., W.M.

Bearing and distance from section or subdivision
corner .860' S. & 315' E. from the NW cor. Sec. 20.

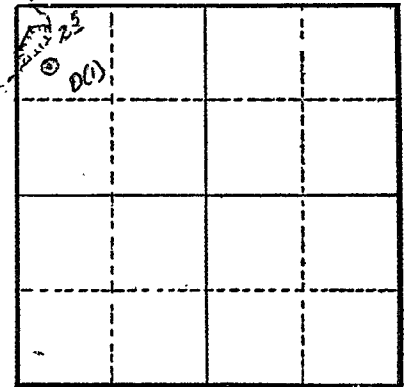

Section 20

Altitude at well 1800 ft.

TYPE OF WELL: Dug Date Constructed 1937

Depth drilled 17 ft. Depth cased 17 ft.

CASING RECORD:

42 inch

FINISH:

AQUIFERS:

WATER LEVEL:

7 ft.

PUMPING EQUIPMENT: Type 1 1/2 x 2 in. Piston H.P. 1

Capacity 25 G.P.M.

WELL TESTS:

Drawdown 4 ft. after _____ hours 25 G.P.M.

Drawdown _____ ft. after _____ hours _____ G.P.M.

USE OF WATER Irrigation Temp. _____ °F. _____, 19_____

SOURCE OF INFORMATION G.R. Record

DRILLER or DIGGER _____

ADDITIONAL DATA:

Log _____ Water Level Measurements _____ Chemical Analysis _____ Aquifer Test _____

REMARKS:

Irrigation of 2.5 acres.