

STATE ENGINEER  
Salem, Oregon

*JACK*  
*35323* Well Record


STATE WELL NO. 38/1W-23E  
COUNTY JACKSON  
APPLICATION NO. GR-2474

OWNER: Stephen G. Nye  
MAILING ADDRESS: Rt. 3, Box 203

LOCATION OF WELL: Owner's No.  
CITY AND STATE: Medford, Oregon

SW 1/4 NW 1/4 Sec. 23 T. 38 N S. R. 1 W., W.M.

Bearing and distance from section or subdivision  
corner 1470' N. and 94' E. from the SW cor., DLC 59

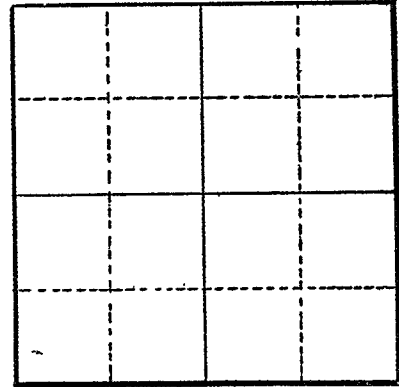

Section .....

Altitude at well .....

TYPE OF WELL: Dug Date Constructed 1940

Depth drilled 6.0 Depth cased 6

CASING RECORD:

24-inch

FINISH:

AQUIFERS:

WATER LEVEL:

2.0-feet

PUMPING EQUIPMENT: Type Centrifugal pump H.P. 4.5  
Capacity ..... G.P.M.

WELL TESTS:

Drawdown ..... ft. after ..... hours ..... G.P.M.  
Drawdown ..... ft. after ..... hours ..... G.P.M.

USE OF WATER Suppl., Irr. & Industrial Temp. °F. ...., 19.....

SOURCE OF INFORMATION GR-2343

DRILLER or DIGGER Fred Schaffel, address unknown

ADDITIONAL DATA:

Log ..... Water Level Measurements ..... Chemical Analysis ..... Aquifer Test .....

REMARKS: