

STATE ENGINEER  
Salem, Oregon

JACK  
35326

# Well Record

STATE WELL NO. 38/1W-26E(1)  
COUNTY Jackson  
APPLICATION NO. GR-273

OWNER: S. E. Trent


MAILING ADDRESS: 539 Pennsylvania Avenue

LOCATION OF WELL: Owner's No. 1

CITY AND STATE: Medford, Oregon

SW 1/4 NW 1/4 Sec. 26 T. 38 N. S., R. 1 E. W., W.M.

Bearing and distance from section or subdivision corner 1535' S. & 141' E. from NW cor. Sec. 26

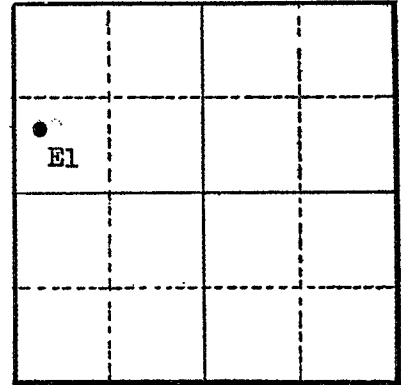

Section 26

Altitude at well 1630' Interpolated

TYPE OF WELL: Dug Date Constructed May 1911

Depth drilled 20 Depth cased 13

### CASING RECORD:

8 x 8' concrete casing set from 0 to 13'  
pumice blocks set from 13 to 20'

### FINISH:

pumice blocks from 13 to 20 feet

### AQUIFERS:

unknown

### WATER LEVEL:

8' below land surface

PUMPING EQUIPMENT: Type 1 1/2" centrifugal H.P. 5  
Capacity 125 G.P.M.

### WELL TESTS:

Drawdown \_\_\_\_\_ ft. after \_\_\_\_\_ hours \_\_\_\_\_ G.P.M.  
Drawdown \_\_\_\_\_ ft. after \_\_\_\_\_ hours \_\_\_\_\_ G.P.M.

USE OF WATER Irrigation 4.36 acres Temp. \_\_\_\_\_ °F., 19

SOURCE OF INFORMATION Registration Statement GR-273

DRILLER or DIGGER \_\_\_\_\_

### ADDITIONAL DATA:

Log No Water Level Measurements \_\_\_\_\_ Chemical Analysis \_\_\_\_\_ Aquifer Test \_\_\_\_\_

### REMARKS: