

STATE ENGINEER
Salem, Oregon

JACK
35327
Well Record

STATE WELL NO. 38/1W-26G(1)
COUNTY Jackson
APPLICATION NO. GR-621

OWNER: Town of Talent

MAILING
ADDRESS: _____


LOCATION OF WELL: Owner's No. 2

CITY AND
STATE: Talent, Oregon

SW $\frac{1}{4}$ NE $\frac{1}{4}$ Sec. 26 T. 38 N. S., R. 1 E. W., W.M.

Bearing and distance from section or subdivision

corner 625' N. & 880' W. from SE cor. DLC 64

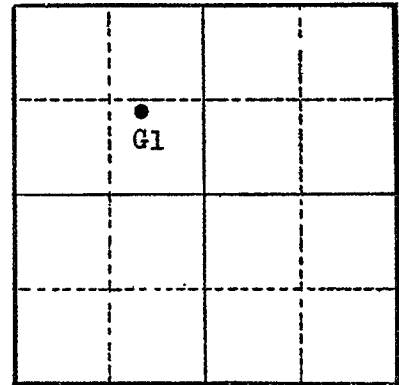

Altitude at well 1650'

TYPE OF WELL: Drilled Date Constructed 1948

Depth drilled 20' Depth cased _____

Section 26

CASING RECORD:

30" 300' long

FINISH:

AQUIFERS:

WATER LEVEL:

8'

PUMPING EQUIPMENT: Type 6" turbine; 2 1/2" centrifugal H.P. 2-15
Capacity _____ G.P.M.

WELL TESTS:

Drawdown 8 ft. after _____ hours _____ G.P.M.

Drawdown _____ ft. after _____ hours _____ G.P.M.

USE OF WATER Municipal Temp. _____ °F., 19 _____

SOURCE OF INFORMATION GR-621

DRILLER or DIGGER Town of Talent

ADDITIONAL DATA:

Log _____ Water Level Measurements _____ Chemical Analysis _____ Aquifer Test _____

REMARKS:

STATE ENGINEER
Salem, Oregon

State Well No. 38/1^W2691

County Jackson

Application No.

Chemical Analysis

OWNER City of Talent OWNER'S NO.

ANALYST USGS Address

Date of Collection 5/21/51

Point of Collection

	P.P.M.	E.P.M.
Silica (SiO ₂)	30.	
Iron (Fe) Total	.07	
Manganese (Mn)	.0	
Calcium (Ca)	85.	
Magnesium (Mg)	18.	
Sodium (Na)	14.	
Potassium (K)	3.4	
Bicarbonate (HCO ₃)	334.	
Carbonate (CO ₃)		
Sulfate (SO ₄)	23.	
Chloride (Cl)	9.0	
Fluoride (F)	.1	
Nitrate (NO ₃)	9.8	
Boron (B)	.04	
Dissolved Solids	357.	
Hardness as CaCO ₃	286.	
Specific Conductance (Micromhos at 25°C)	567.	
pH	7.0	
Percent Sodium	10.	
Sodium Absorption Ratio (S.A.R.)	.36	
CLASS		