

STATE ENGINEER  
Salem, Oregon

JACK  
35329

# Well Record


STATE WELL NO. 38/1W-26N  
COUNTY Jackson  
APPLICATION NO. GR-942

OWNER: Harry N. & Louella M. Gleim MAILING ADDRESS: Route 1, Box 575

LOCATION OF WELL: Owner's No. CITY AND STATE: Talent, Oregon

SW 1/4 SW 1/4 Sec. 26 T. 38 N. S. R. 1 E. W., W.M.

Bearing and distance from section or subdivision corner 325' N. & 200' W. from SE cor. DLC 63

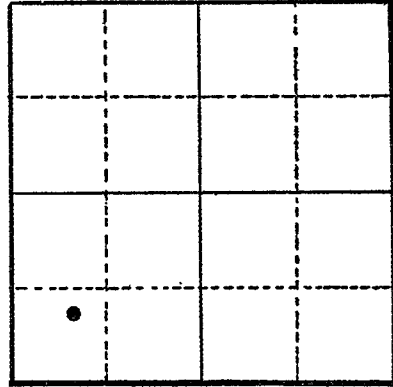

Section 26

Altitude at well 1700

TYPE OF WELL: Dug Date Constructed 1940

Depth drilled 12 Depth cased

### CASING RECORD:

### FINISH:

Dug trench (open) 70 x 30'  
Discharge 50 gpm

### AQUIFERS:

Gravel 9 to 12'

### WATER LEVEL:

2'

PUMPING EQUIPMENT: Type 1 1/2" centrifugal H.P. 2 Elec.

Capacity 50 G.P.M.

### WELL TESTS:

Drawdown ft. after hours G.P.M.  
Drawdown ft. after hours G.P.M.

USE OF WATER Supplemental Irrigation Temp. °F., 19

SOURCE OF INFORMATION Owner

### DRILLER or DIGGER

### ADDITIONAL DATA:

Log  Water Level Measurements Chemical Analysis Aquifer Test

### REMARKS:

Log: Clay loam 0 to 7  
Fine sand 7 to 9  
Gravel 9 to 12