

STATE ENGINEER
Salem, Oregon

JACK
35333 **Well Record**


STATE WELL NO. 38/1W-27H(1)
COUNTY Jackson
APPLICATION NO. GR-620

OWNER: Town of Talent MAILING ADDRESS: City Hall

LOCATION OF WELL: Owner's No. 1 CITY AND STATE: Talent, Oregon

SE 1/4 NE 1/4 Sec. 27 T. 38 N. S., R. 1 E. W., W.M.

Bearing and distance from section or subdivision
corner 3575' N. & 1406' E. of SW cor. DLG 63

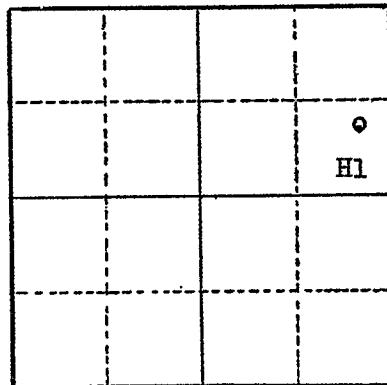

Section 27

Altitude at well 1700' Interpolated

TYPE OF WELL: Dug Date Constructed July 1912

Depth drilled 41 1/2' Depth cased 41 1/2'

CASING RECORD:

180 inch

FINISH:

AQUIFERS:

WATER LEVEL:

30 feet

PUMPING EQUIPMENT: Type 2" jet & 3" centrifugal H.P. 5 & 7 1/2
Capacity G.P.M.

WELL TESTS:

Drawdown 20 ft. after hours 125 G.P.M.
Drawdown ft. after hours G.P.M.

USE OF WATER Municipal Temp. °F. , 19

SOURCE OF INFORMATION GR-620

DRILLER or DIGGER

ADDITIONAL DATA:

Log Water Level Measurements Chemical Analysis Aquifer Test

REMARKS: