

STATE ENGINEER
Salem, Oregon

Well Record


STATE WELL NO. 38/1W-27K(1)
COUNTY Jackson
APPLICATION NO. GR-129

35335

OWNER: Joe H. & Lorraine A. Meyer MAILING ADDRESS: Route 1, Box 413

LOCATION OF WELL: Owner's No. 1 CITY AND STATE: Talent, Oregon

NW 1/4 SE 1/4 Sec. 27 T. 38 N. S. R. 1 W., W.M.
Bearing and distance from section or subdivision corner 100' S. & 280' E from center Sec. 27

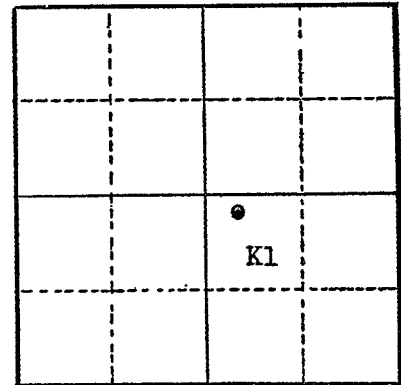

Altitude at well 1540' Interpolated

TYPE OF WELL: Dug Date Constructed Oct. 54
Sump
Depth drilled 25 Depth cased

Section 27

CASING RECORD:

Open sump 220' x 45' (wide) x 20 to 25' (deep)

FINISH:

None

AQUIFERS:

Unknown

WATER LEVEL:

10 to 12 feet below land surface

PUMPING EQUIPMENT: Type Bryon Jackson centrifugal 3" H.P. 40
Capacity 350 G.P.M.

WELL TESTS:

Drawdown ft. after hours G.P.M.
Drawdown ft. after hours G.P.M.

USE OF WATER Irrigation 60 acres Temp. °F., 19
SOURCE OF INFORMATION Registration Statement GR-129

DRILLER or DIGGER

ADDITIONAL DATA:

Log No. Water Level Measurements Chemical Analysis Aquifer Test

REMARKS: