

STATE ENGINEER
Salem, Oregon


JACK
35370 Well Record

STATE WELL NO. 36/2-250
COUNTY Jackson
APPLICATION NO. GR-2267

OWNER: Orval Ingram
MAILING ADDRESS: 6134 Table Rock

LOCATION OF WELL: Owner's No. _____
CITY AND STATE: Central Point, Oregon

SW 1/4 SE 1/4 Sec. 25 T. 36 S., R. 2 W., W.M.
Bearing and distance from section or subdivision
corner 767' N & 111' E from the SW corner Sec. 25

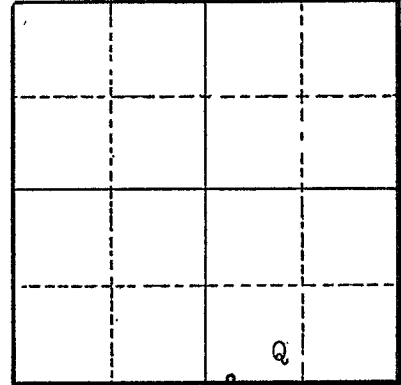

Section 25

Altitude at well 1265'

TYPE OF WELL: Drilled Date Constructed 9/53

Depth drilled 32' Depth cased 30'

CASING RECORD:

36-inch

FINISH:

AQUIFERS:

WATER LEVEL:

25'

PUMPING EQUIPMENT: Type Jacuzzi Jet H.P. 1
Capacity 17 G.P.M.

WELL TESTS:

Drawdown _____ ft. after _____ hours _____ G.P.M.
Drawdown _____ ft. after _____ hours _____ G.P.M.

USE OF WATER Irrigation Temp. _____ °F. _____, 19

SOURCE OF INFORMATION GR-4006

DRILLER or DIGGER Goff Bros. Well Drilling, 225 W. Main St., Medford, Oregon

ADDITIONAL DATA:

Log NA Water Level Measurements _____ Chemical Analysis _____ Aquifer Test _____

REMARKS: