

STATE ENGINEER
Salem, Oregon

Well Record

STATE WELL NO. 37/1W-32P
COUNTY Jackson
APPLICATION NO. GR-1715

Jack
35398

GR- 1664

OWNER: Harry & David, An Oregon Corp.

MAILING ADDRESS: P. O. Box 712


LOCATION OF WELL: Owner's No.

CITY AND STATE: Medford, Oregon

SE 1/4 SW 1/4 Sec. 32 T. 37 S., R. 1 W., W.M.

Bearing and distance from section or subdivision

corner 376' S. & 55' W. from NE cor. DIC #41

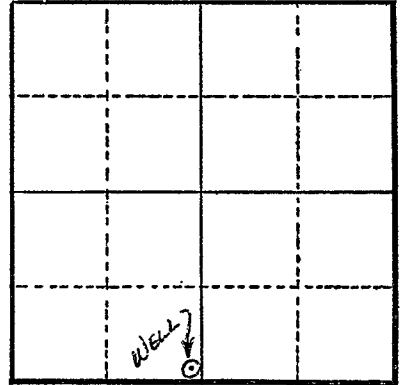

Section 32

Altitude at well 1410'

TYPE OF WELL: Dug Date Constructed Prior to 1900

Depth drilled 14' Depth cased

CASING RECORD:

? 72"

FINISH:

AQUIFERS:

WATER LEVEL:

12'

PUMPING EQUIPMENT: Type 2 Cent.- Berkeley 1 1/2" & Deming 2" H.P. 5 & 10
Capacity 90 & 160 G.P.M.

WELL TESTS:

Drawdown 14 ft. after 250 hours G.P.M.

Drawdown 7 ft. after 160 hours G.P.M.

USE OF WATER Manufacturing & Domestic Temp. °F. 19

SOURCE OF INFORMATION GR Record

DRILLER or DIGGER

ADDITIONAL DATA:

Log N.A. Water Level Measurements Chemical Analysis Aquifer Test

REMARKS: