

STATE ENGINEER  
Salem, Oregon

*JACK*  
*35435* Well Record

STATE WELL NO. *37/2W-26F*  
COUNTY *Jackson*  
APPLICATION NO. *GR-1798*

GR- 1738

OWNER: *Donald A. Bunyard*


MAILING ADDRESS: *2748 Jacksonville Hwy.*

LOCATION OF WELL: Owner's No. \_\_\_\_\_

CITY AND STATE: *Medford, Oregon*

*SE* 1/4 *NW* 1/4 Sec. *26* T. *37* S., R. *2* W., W.M.

Bearing and distance from section or subdivision corner *265' E. & 750' S. from NW cor. DIC #76*

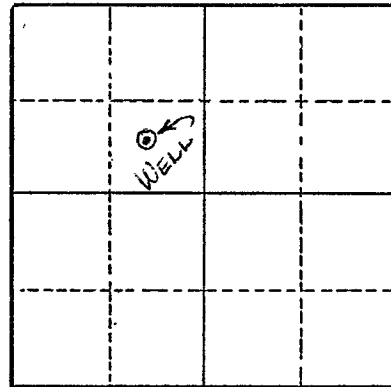

Section *26*

Altitude at well *1400'*

TYPE OF WELL: *Dug* Date Constructed *1920*

Depth drilled *20'* Depth cased *20'*

CASING RECORD:

*42" rock cribbing*

FINISH:

AQUIFERS:

WATER LEVEL:

*1'*

PUMPING EQUIPMENT: Type *1" Cent.* H.P. *1 1/2*  
Capacity *30* G.P.M.

WELL TESTS:

Drawdown *4* ft. after \_\_\_\_\_ hours *30* G.P.M.

Drawdown \_\_\_\_\_ ft. after \_\_\_\_\_ hours \_\_\_\_\_ G.P.M.

USE OF WATER *Irrigation* Temp. \_\_\_\_\_ °F. \_\_\_\_\_, 19\_\_\_\_

SOURCE OF INFORMATION *GR Record*

DRILLER or DIGGER \_\_\_\_\_

ADDITIONAL DATA:

Log \_\_\_\_\_ Water Level Measurements \_\_\_\_\_ Chemical Analysis \_\_\_\_\_ Aquifer Test \_\_\_\_\_

REMARKS:

Log: *Black silty clay* 0 to 2 ft.  
*Yellowish silty clay* 2 to 20 ft. Some granulation, water bearing strata interspersed.

*Irrigation of 3 acres.*