

STATE ENGINEER
Salem, Oregon

JACK
35436
Well Record


STATE WELL NO. 37/2W-26F(1)
COUNTY Jackson
APPLICATION NO. GR-768

OWNER: Thomas Grant & Frances E. MAILING ADDRESS: 2728 Jacksonville Hwy.

LOCATION OF WELL: Owner's No. 1 CITY AND STATE: Medford, Oregon

SE 1/4 NW 1/4 Sec. 26 T. 37 N. S. R. 2 E. W., W.M.

Bearing and distance from section or subdivision corner 389' E & 759' S. of NW cor. DLC 76

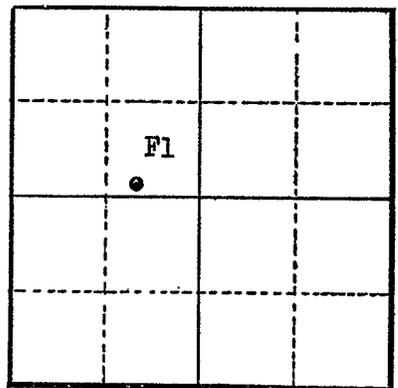

Section 26

Altitude at well 1410' Interpolated

TYPE OF WELL: Dug Date Constructed 1928

Depth drilled 14' Depth cased 14'

CASING RECORD:

48" x 48" concrete

FINISH:

AQUIFERS:

WATER LEVEL:

1'

PUMPING EQUIPMENT: Type Elect. Berkeley cent. 1 in. H.P. 1
Capacity 40 G.P.M.

WELL TESTS:

Drawdown 4 ft. after hours 40 G.P.M.
Drawdown ft. after hours G.P.M.

USE OF WATER Irrigation Temp. °F. 19
SOURCE OF INFORMATION GR-768

DRILLER or DIGGER

ADDITIONAL DATA:

Log No. Water Level Measurements Chemical Analysis Aquifer Test

REMARKS:

Log unknown but probably:
Black silty clay 0 to 3'
Yellow silty clay with sand and gravelly strata 3 to 11'