

STATE ENGINEER  
Salem, Oregon

JACK  
35438  
Well Record


STATE WELL NO. 37/2W-26K(1)  
COUNTY Jackson  
APPLICATION NO. GR-523

OWNER: Ernest & Verla Santo MAILING ADDRESS: 204 Lazier Lane

LOCATION OF WELL: Owner's No. CITY AND STATE:

NW 1/4 SE 1/4 Sec. 26 T. 37 N. S., R. 2 E. W., W.M.

Bearing and distance from section or subdivision corner 615' N. & 955' W. from SE cor. DLC 76

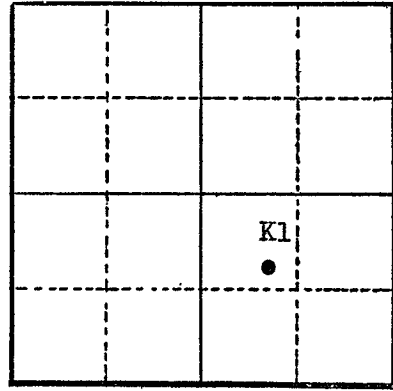

Section 26

Altitude at well 1410'

TYPE OF WELL: Drilled Date Constructed July '50

Depth drilled 100.5' Depth cased ?

CASING RECORD:  
6-inch

FINISH:

AQUIFERS:

WATER LEVEL:  
6'

PUMPING EQUIPMENT: Type Jacuzzi jet H.P. 1  
Capacity 10 G.P.M.

WELL TESTS:  
Drawdown ft. after hours G.P.M.  
Drawdown ft. after hours G.P.M.

USE OF WATER Irrigation 2 acres Temp. °F., 19

SOURCE OF INFORMATION GR-523

DRILLER or DIGGER Goff Bros. Medford, Oregon

ADDITIONAL DATA:  
Log No Water Level Measurements Chemical Analysis Aquifer Test

REMARKS: