

STATE ENGINEER
Salem, Oregon

JACK
35439 Well Record


STATE WELL NO. 37/2W-26M(1)
COUNTY Jackson
APPLICATION NO. GR-570

OWNER: Allen Perry Perrydale Orchards MAILING ADDRESS: 105 Geneva Avenue

LOCATION OF WELL: Owner's No. 1 CITY AND STATE: Medford, Oregon

NW 1/4 SW 1/4 Sec. 26 T. 37 N. S., R. 2 E. W., W.M.

Bearing and distance from section or subdivision corner 896' S. & 360' E. from NE cor. DLC 74

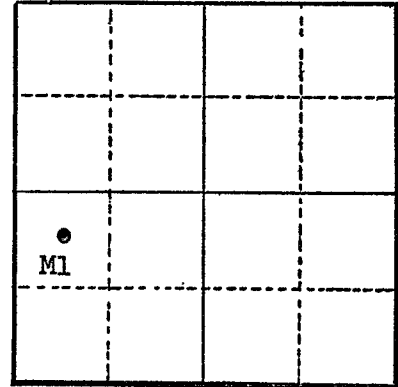

Section 26

Altitude at well 1420

TYPE OF WELL: Dug Date Constructed April '48

Depth drilled 12 Depth cased

CASING RECORD:

12' x 12' pit

FINISH:

AQUIFERS:

WATER LEVEL:

4'

PUMPING EQUIPMENT: Type Gould centrifugal H.P. 6
Capacity 60 G.P.M.

WELL TESTS:

Drawdown ft. after hours G.P.M.

Drawdown ft. after hours G.P.M.

USE OF WATER Irrigation 3 acres Temp. °F., 19

SOURCE OF INFORMATION GR-570

DRILLER or DIGGER

ADDITIONAL DATA:

Log Water Level Measurements Chemical Analysis Aquifer Test

REMARKS:

Sandy loam 3 to 9'
Gravel 0 to 3'