

STATE ENGINEER
Salem, Oregon

JACK
35440 Well Record

STATE WELL NO. 37/2W-26M(2)
COUNTY Jackson
APPLICATION NO. GR-579

OWNER: Allen Parry Perrydale
Orchards

MAILING ADDRESS: 105 Geneva Avenue

LOCATION OF WELL: Owner's No. 2


CITY AND STATE: Medford, Oregon

NW 1/4 SW 1/4 Sec. 26 T. 37 N. S., R. 2 E. W., W.M.

Bearing and distance from section or subdivision

corner

Altitude at well 1400

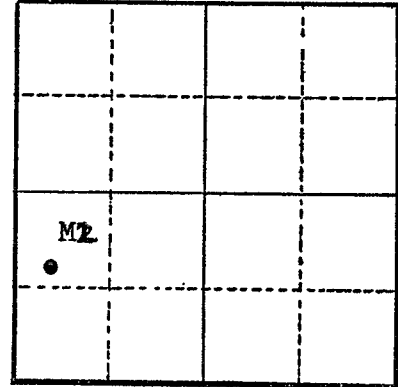

Section 26

TYPE OF WELL: Dug Date Constructed May 18, '55

Depth drilled 18 Depth cased

CASING RECORD:

20' x 125' trench

FINISH:

AQUIFERS:

WATER LEVEL:

5'

PUMPING EQUIPMENT: Type Gould centrifugal H.P. 6
Capacity 60 G.P.M.

WELL TESTS:

Drawdown ft. after hours G.P.M.

Drawdown ft. after hours G.P.M.

USE OF WATER Irrigation 6 acres Temp. °F., 19

SOURCE OF INFORMATION GR-579

DRILLER or DIGGER

ADDITIONAL DATA:

Log Water Level Measurements Chemical Analysis Aquifer Test

REMARKS:

Sandy loam 10 to 18'
Gravel 8 to 10'
Clay 1 to 8'
Gravel 0 to 1'