

STATE ENGINEER  
Salem, Oregon

JACK  
35445  
Well Record

STATE WELL NO. 37/2W-27K  
COUNTY Jackson  
APPLICATION NO. GR-893

OWNER: Lyle B. Thurman


MAILING ADDRESS: 3379 Jacksonville Hwy.

LOCATION OF WELL: Owner's No. 1

CITY AND STATE: Medford, Oregon

NW 1/4 SE 1/4 Sec. 27 T. 37 N. S., R. 2 E. W., W.M.

Bearing and distance from section or subdivision corner 130' S. & 1884' W. from NE cor. DLC 74

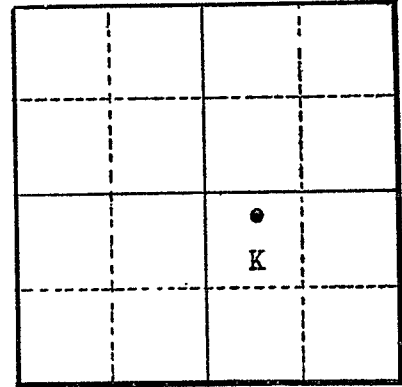

Altitude at well 1420

TYPE OF WELL: Dug Date Constructed 1922

Depth drilled 22 Depth cased 22

Section 27

CASING RECORD:

FINISH:

Dug well 50" diameter brick finish

AQUIFERS:

WATER LEVEL:

8

PUMPING EQUIPMENT: Type Jacuzzi 2 x 1 1/2" centrifugal H.P. 1 Elec.  
Capacity 40 G.P.M.

WELL TESTS:

Drawdown 0 ft. after 40 hours G.P.M.  
Drawdown ft. after hours G.P.M.

USE OF WATER Irrigation Temp. °F., 19

SOURCE OF INFORMATION Owner

DRILLER or DIGGER

ADDITIONAL DATA:

Log NA Water Level Measurements Chemical Analysis Aquifer Test

REMARKS: