

STATE ENGINEER
Salem, Oregon

JACK
35460 Well Record

STATE WELL NO. 37/2W-27M(1)
COUNTY Jackson
APPLICATION NO. GR-746

OWNER: O. D. & Vergia Day


MAILING ADDRESS: 85 Arnold Lane

LOCATION OF WELL: Owner's No.

CITY AND STATE: Medford, Oregon

NW 1/4 SW 1/4 Sec. 27 T. 37 S., R. 2 W., W.M.

Bearing and distance from section or subdivision corner 489' S. & 163' E. from NW cor. DLC 74

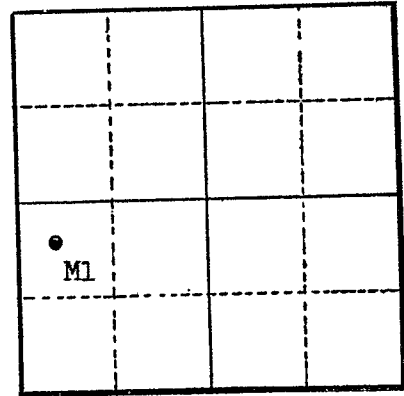

Altitude at well 1412' Interpolated

Section 27

TYPE OF WELL: Drilled Date Constructed 1949

Depth drilled 13' Depth cased 13'

CASING RECORD:

10-inch from 0 to 13' (concrete)

FINISH:

Lower 4' of casing perforated 80 1/2" perforations

AQUIFERS:

WATER LEVEL:

3.5'

PUMPING EQUIPMENT: Type 2 gas engines 2 cent. Berkeley 1.25 & 1 in. H.P. 5 & 9
Capacity 80 G.P.M.

WELL TESTS:

Drawdown 4 ft. after _____ hours _____ G.P.M.
Drawdown _____ ft. after _____ hours _____ G.P.M.

USE OF WATER Irrigation Temp. _____ °F. _____, 19_____

SOURCE OF INFORMATION GR-746

DRILLER or DIGGER

ADDITIONAL DATA:
Log Water Level Measurements _____ Chemical Analysis _____ Aquifer Test _____

REMARKS:

