

STATE ENGINEER
Salem, Oregon

JACK
35461 Well Record

STATE WELL NO. 37/2W-27K
COUNTY Jackson
APPLICATION NO. GR-3189

OWNER: Walter L. Wilson and
Bernice L. Wilson


MAILING ADDRESS: 232 Janney Lane

LOCATION OF WELL: Owner's No. # 2

CITY AND STATE: Medford, Oregon

NW 1/4 SE 1/4 Sec. 27 T. 37 N. S. R. 2 E. W., W.M.

Bearing and distance from section or subdivision
corner 131 feet North and 586 feet West from
the SE Corner, Lot 12

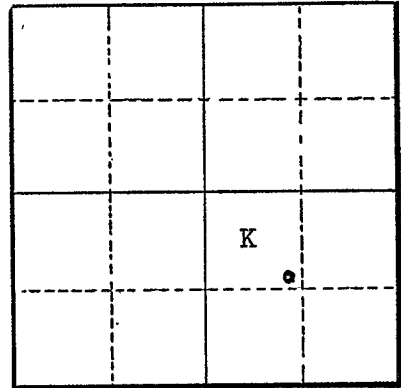

Section 27

Altitude at well 1600 feet

TYPE OF WELL: Dug Date Constructed June, 1953

Depth drilled 15 feet Depth cased

CASING RECORD:

FINISH:

AQUIFERS:

WATER LEVEL:

3 feet 10 inches

PUMPING EQUIPMENT: Type Centrifugal 1" intake 3/4" discharge H.P.
Capacity 10 G.P.M.

WELL TESTS:

Drawdown none ft. after hours 10 G.P.M.
Drawdown ft. after hours G.P.M.

USE OF WATER Irrigation Temp. °F., 19

SOURCE OF INFORMATION GR-4079

DRILLER or DIGGER by claimant's son

ADDITIONAL DATA:

Log (NA) Water Level Measurements Chemical Analysis Aquifer Test

REMARKS: