

STATE ENGINEER
Salem, Oregon

JACK
35488

Well Record

STATE WELL NO. 37/2W-30A
COUNTY Jackson
APPLICATION NO. GR-3190

OWNER: Anna P. Liveingston


MAILING ADDRESS: Route 2, Box 469

LOCATION OF WELL: Owner's No.

CITY AND STATE: Medford, Oregon

NE 1/4 NE 1/4 Sec. 30 T. 37 ~~N~~ S., R. 2 ~~E~~ W., W.M.

Bearing and distance from section or subdivision corner 545' S. and 410' W.

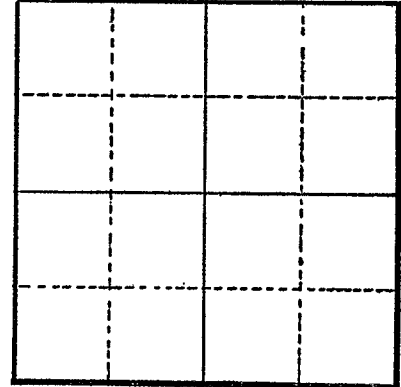

Section

Altitude at well

TYPE OF WELL: drilled Date Constructed 1915

Depth drilled 230 Depth cased unknown

CASING RECORD:

6-inch

FINISH:

AQUIFERS:

WATER LEVEL:

80'

PUMPING EQUIPMENT: Type a repulsion induction General Electric H.P. 5
Capacity 20' G.P.M.

WELL TESTS:

Drawdown ft. after hours pumping 20 G.P.M.

Drawdown ft. after hours G.P.M.

USE OF WATER Irrigation Temp. °F., 19

SOURCE OF INFORMATION GR-2972

DRILLER or DIGGER

ADDITIONAL DATA:

Log Water Level Measurements Chemical Analysis Aquifer Test

REMARKS: