

STATE ENGINEER
Salem, Oregon

JACK
35487

Well Record

STATE WELL NO. 37/2W-32B
COUNTY JACKSON
APPLICATION NO. GR-2634

OWNER: Joseph E. McIntyre and Thelma C. McIntyre, husband and wife


MAILING ADDRESS: P. O. Box 25 (200 8th St.)

LOCATION OF WELL: Owner's No.

CITY AND STATE: Jacksonville, Oregon

NW 1/4 NE 1/4 Sec. 32 T. 37 S, R. 2 W, W.M.

Bearing and distance from section or subdivision corner 2050' W. and 1000' S.

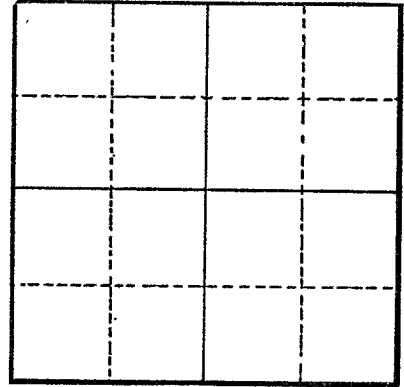

Section

Altitude at well

TYPE OF WELL: Drilled Date Constructed 1953

Depth drilled 53 Depth cased 50

CASING RECORD:

6-inch

FINISH:

AQUIFERS:

WATER LEVEL:

8-feet

PUMPING EQUIPMENT: Type Jacuzzi Jet Injector H.P. 1
Capacity 15 G.P.M.

WELL TESTS:

Drawdown ft. after hours Pumping 1800 gph G.P.M.

Drawdown ft. after hours G.P.M.

USE OF WATER Supplemental Irrigation Temp. °F. 19

SOURCE OF INFORMATION GR-2498

DRILLER or DIGGER Virgil Goff, 556 Beall Lane, Medford, Oregon

ADDITIONAL DATA:

Log Water Level Measurements Chemical Analysis Aquifer Test

REMARKS: