

STATE ENGINEER
Salem, Oregon

JACK
35489

Well Record

STATE WELL NO. 37/2W - 33M
COUNTY JACKSON
APPLICATION NO. GR-2247

OWNER: Roy V. Martin


MAILING ADDRESS: Rt. 4, Box 305

LOCATION OF WELL: Owner's No.

CITY AND STATE: Medford, Oregon

NW 1/4 SW 1/4 Sec. 33 T. 37 N. S., R. 2 E. W., W.M.

Bearing and distance from section or subdivision corner 1221' E. and 19' S.

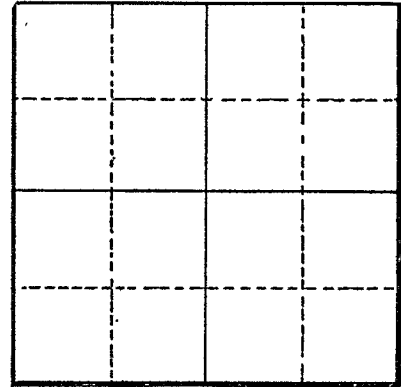

Section

Altitude at well

TYPE OF WELL: Dug Date Constructed 1953

Depth drilled 55 Depth cased 55

CASING RECORD:

40-Inch

FINISH:

AQUIFERS:

WATER LEVEL:

4-Feet

PUMPING EQUIPMENT: Type Centrifugal Peerless H.P. 1
Capacity G.P.M.

WELL TESTS:

Drawdown ft. after hours G.P.M.

Drawdown ft. after hours G.P.M.

USE OF WATER Supplemental irrigation Temp. °F. 19
SOURCE OF INFORMATION GR-2142

DRILLER or DIGGER By claimant

ADDITIONAL DATA:

Log Water Level Measurements Chemical Analysis Aquifer Test

REMARKS: