

STATE ENGINEER
Salem, Oregon

*TACK
35500*

Well Record

STATE WELL NO. 37/2W-34E(2)
COUNTY Jackson
APPLICATION NO. GR-1100

GR- 1061

OWNER: Memory Gardens by Wm. S. Ferris,
Manager


MAILING ADDRESS: 1395 Arnold Lane

LOCATION OF WELL: Owner's No. _____

CITY AND STATE: Medford, Oregon

SW NW
SE ¼ NW ¼ Sec. 34 T. 37 S., R. 2 W., W.M.

Bearing and distance from section or subdivision
corner 952' N. & 744' E. from SW cor. of DIC #78.
(to pump)

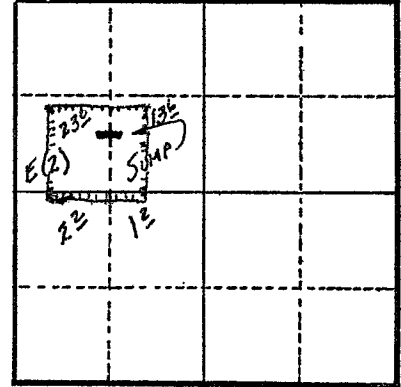

Section 34

Altitude at well 1460 ft.

TYPE OF WELL: Dug Date Constructed 1954

Depth drilled 14 ft. Depth cased Sump

CASING RECORD:

Infiltration trench - 70' x 200' x 14'

FINISH:

AQUIFERS:

WATER LEVEL:

1 ft.

PUMPING EQUIPMENT: Type 2½ in. Cent.

H.P. 15

Capacity 300 G.P.M.

WELL TESTS:

Drawdown _____ ft. after _____ hours _____ G.P.M.

Drawdown _____ ft. after _____ hours _____ G.P.M.

USE OF WATER Irrigation Temp. _____ °F., 19

SOURCE OF INFORMATION G. R. Record

DRILLER or DIGGER _____

ADDITIONAL DATA:

Log _____ Water Level Measurements _____ Chemical Analysis _____ Aquifer Test _____

REMARKS:

Log: Clay loam 0 to 9 ft.
Cement gravel 9 to 14 ft.

Irrigation of 40 acres.