

STATE ENGINEER  
Salem, Oregon

JACK  
35501

# Well Record

STATE WELL NO. 37/2W-34F(1)  
COUNTY Jackson  
APPLICATION NO. GR-464

OWNER: Mrs. Kate S. Nelson


MAILING ADDRESS: 3378 Billinger Lane

LOCATION OF WELL: Owner's No. #3

CITY AND STATE: Medford, Oregon

SE 1/4 NW 1/4 Sec. 34 T. 37 N. S., R. 2 E. W., W.M.

Bearing and distance from section or subdivision  
corner 800' N. & 1330' E. from SW cor. DLC 78

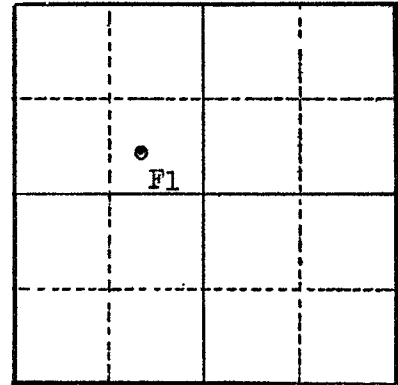

Section 34

Altitude at well 1450

TYPE OF WELL: Dug Date Constructed 1950

Depth drilled 20 Depth cased

CASING RECORD:  
30' x 60'

FINISH:

AQUIFERS:

WATER LEVEL:

20

PUMPING EQUIPMENT: Type Centrifugal H.P. 27  
Capacity 255 G.P.M.

WELL TESTS:

Drawdown ft. after hours G.P.M.

Drawdown ft. after hours G.P.M.

USE OF WATER Irrigation 45 acres Temp. °F. 19

SOURCE OF INFORMATION GR-464

DRILLER or DIGGER

ADDITIONAL DATA:

Log No Water Level Measurements Chemical Analysis Aquifer Test

REMARKS: