

STATE ENGINEER
Salem, Oregon

*JACK
35502*

Well Record

STATE WELL NO. 37/2W-34G(2)
COUNTY Jackson
APPLICATION NO. GR-464

OWNER: Mrs. Kate S. Nelson


MAILING ADDRESS: 3378 Billinger Lane

LOCATION OF WELL: Owner's No. #2

CITY AND STATE: Medford, Oregon

SW $\frac{1}{4}$ NE $\frac{1}{4}$ Sec. 34 T. 37 N. S., R. 2 E. W., W.M.

Bearing and distance from section or subdivision corner 735' N & 2870' E. from SW cor. DLC 78

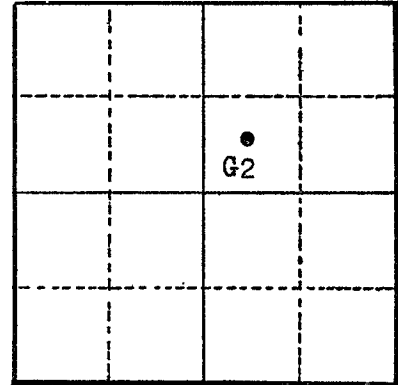

Section 34

Altitude at well 1450

TYPE OF WELL: Drilled Date Constructed Dec. '49

Depth drilled 98 Depth cased ?

CASING RECORD:

6-inch

FINISH:

AQUIFERS:

WATER LEVEL:

10 (est.)

PUMPING EQUIPMENT: Type Submersible H.P. 1/2
Capacity 10 (est.) G.P.M.

WELL TESTS:

Drawdown _____ ft. after _____ hours _____ G.P.M.

Drawdown _____ ft. after _____ hours _____ G.P.M.

USE OF WATER Irrigation 1 acre Temp. _____ °F., 19 _____

SOURCE OF INFORMATION GR-464

DRILLER or DIGGER Myron D. Andrews Medford, Oregon

ADDITIONAL DATA:

Log No Water Level Measurements _____ Chemical Analysis _____ Aquifer Test _____

REMARKS: