

STATE ENGINEER
Salem, Oregon

JACK
35506

Well Record


STATE WELL NO. 37/2W-35D(1)
COUNTY Jackson
APPLICATION NO. GR-351

OWNER: A. W. Denny MAILING ADDRESS: 2995 Madronna Lane

LOCATION OF WELL: Owner's No. CITY AND STATE: Medford, Oregon

NW 1/4 NW 1/4 Sec. 35 T. 37 N. S., R. 2 E. W., W.M.

Bearing and distance from section or subdivision corner 254' S. & 28' E. from NE cor. DLG 58

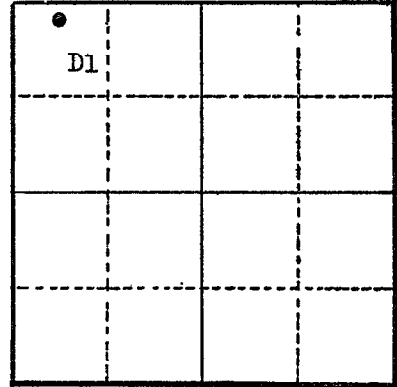

Section 35

Altitude at well 1425

TYPE OF WELL: Dug Date Constructed April 1, 1940

Depth drilled 9 Depth cased none

CASING RECORD:

none

FINISH:

AQUIFERS:

WATER LEVEL:

4 feet

PUMPING EQUIPMENT: Type centrifugal H.P. 3
Capacity 160 G.P.M.

WELL TESTS:

Drawdown ft. after hours G.P.M.
Drawdown ft. after hours G.P.M.

USE OF WATER Irrigation Temp. °F., 19

SOURCE OF INFORMATION Registration Statement

DRILLER or DIGGER

ADDITIONAL DATA:

Log No Water Level Measurements Chemical Analysis Aquifer Test

REMARKS:

Infiltration trench
244' long
40' wide
4-6' deep