

STATE ENGINEER
Salem, Oregon

JACK
35508

Well Record


STATE WELL NO. 37/2W-35D
COUNTY JACKSON
APPLICATION NO. GR-2513

OWNER: Max A. Cramer & Sarah Kim Cramer MAILING ADDRESS: 3185 Madrona Lane.

LOCATION OF WELL: Owner's No. #2 CITY AND STATE: Medford, Oregon

NW 1/4 NW 1/4 Sec. 35 T. 37 N. S. R. 2 W., W.M.

Bearing and distance from section or subdivision corner 147' S. & 853' W. from the SE cor. DLC #75

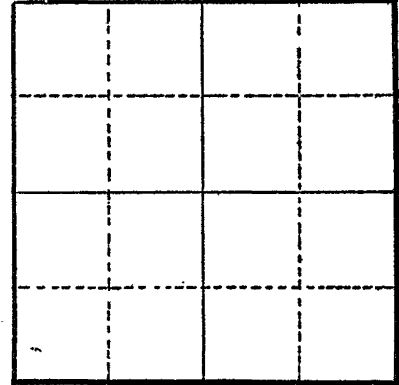

Section

Altitude at well

TYPE OF WELL: Drilled Date Constructed 1946

Depth drilled 55 Depth cased 55

CASING RECORD:

8-inch

FINISH:

AQUIFERS:

WATER LEVEL:

12-feet

PUMPING EQUIPMENT: Type (Jet) centrifugal pump H.P. 1/2
Capacity 10 G.P.M.

WELL TESTS:

Drawdown ft. after hours G.P.M.
Drawdown ft. after hours G.P.M.

USE OF WATER Irrigation Temp. °F. , 19

SOURCE OF INFORMATION GR-2380

DRILLER or DIGGER Goff Bros., Medford, Oregon

ADDITIONAL DATA:

Log Water Level Measurements Chemical Analysis Aquifer Test

REMARKS: