

STATE ENGINEER  
Salem, Oregon

JACK  
35509

# Well Record


STATE WELL NO. 37/2W-350  
COUNTY Jackson  
APPLICATION NO. GR-3645

OWNER: Lloyd H. Tenney  
MAILING ADDRESS: 1730 Thomas Road

LOCATION OF WELL: Owner's No. \_\_\_\_\_  
CITY AND STATE: Medford, Oregon

SW 1/4 SE 1/4 Sec. 35 T. 37 S. R. 2 W., W.M.

Bearing and distance from section or subdivision  
corner 1261' N. & 945' E. from the SE cor. D.L.C. #41

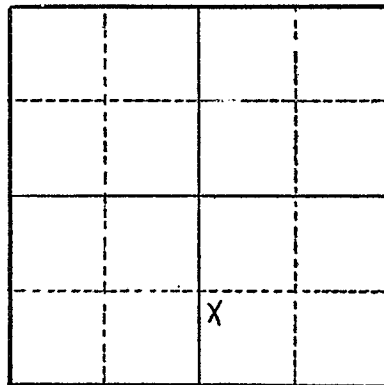

Section 35

Altitude at well \_\_\_\_\_

TYPE OF WELL: dug Date Constructed 1929

Depth drilled 15 feet Depth cased \_\_\_\_\_

### CASING RECORD:

### FINISH:

### AQUIFERS:

### WATER LEVEL:

2.0 feet below surface

PUMPING EQUIPMENT: Type 2" centrifugal electric motor H.P. 1 1/2  
Capacity \_\_\_\_\_ G.P.M.

### WELL TESTS:

Drawdown \_\_\_\_\_ ft. after \_\_\_\_\_ hours \_\_\_\_\_ G.P.M.

Drawdown \_\_\_\_\_ ft. after \_\_\_\_\_ hours \_\_\_\_\_ G.P.M.

USE OF WATER Irrigation Temp. \_\_\_\_\_ °F., 19 \_\_\_\_\_

SOURCE OF INFORMATION Well Registration Statement

DRILLER or DIGGER Alfred D. Flanary

### ADDITIONAL DATA:

Log \_\_\_\_\_ Water Level Measurements \_\_\_\_\_ Chemical Analysis \_\_\_\_\_ Aquifer Test \_\_\_\_\_

### REMARKS: