

STATE ENGINEER
Salem, Oregon

Well Record

STATE WELL NO. 37/2W-29B
COUNTY Jackson
APPLICATION NO. GR-1456

GR- 1405

OWNER: Wayne Major


MAILING ADDRESS: P.O. Box 447

LOCATION OF WELL: Owner's No. _____

CITY AND STATE: Jacksonville, Oregon

SE 1/4 SE 1/4 Sec. 29 T. 37 ^{XX} S., R. 2 ^{EX} W., W.M.

Bearing and distance from section or subdivision
corner 1077' S. & 1616' E. from NW cor. DIC #90

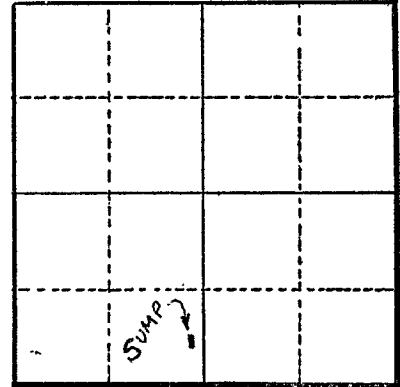

Altitude at well 1490'

TYPE OF WELL: Dug Date Constructed 1954

Depth drilled 12' Depth cased Sump

Section 29

CASING RECORD:

Infiltration trench - 35' x 15' x 12'

FINISH:

AQUIFERS:

WATER LEVEL:

6'

PUMPING EQUIPMENT: Type Pacific 1 1/2" x 2" Cent. H.P. 5
Capacity 100 G.P.M.

WELL TESTS:

Drawdown 1 ft. after 1 hours 100 G.P.M.

Drawdown _____ ft. after _____ hours _____ G.P.M.

USE OF WATER Irrigation Temp. _____ °F., 19_____

SOURCE OF INFORMATION GR Record

DRILLER or DIGGER _____

ADDITIONAL DATA:

Log _____ Water Level Measurements _____ Chemical Analysis _____ Aquifer Test _____

REMARKS:

Log: Top soil 0 to 8'
Clay, some sandy (water) 8' to 12'

Irrigation of 4 acres.