

JACK
3566

GR- 1479

OWNER: V. R. & Lela R. Bonham

MAILING

ADDRESS: Rt. 2, Box 578B

LOCATION OF WELL: Owner's No.

CITY AND

STATE: Central Point, Oregon

NW ¼ SE ¼ Sec. 14 T. 35 ~~XXX~~ S, R. 2 ~~XX~~ W., W.M.

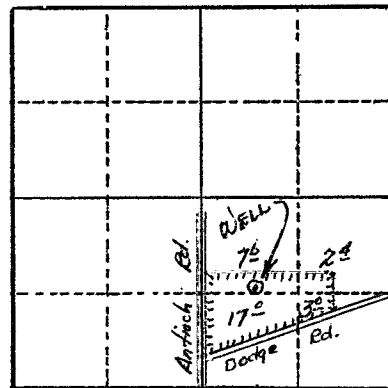
Bearing and distance from section or subdivision

corner 1380' N. & 1895' W. from SE cor. Sec. 14

Altitude at well 1365'

TYPE OF WELL: Drilled Date Constructed 1924

Depth drilled 500' Depth cased 60'

Section 14

CASING RECORD:

6"

FINISH:

AQUIFERS:

Sand stone formation at 472'

WATER LEVEL:

13:

PUMPING EQUIPMENT: Type Red Jacket submersible 2" H.P. 5

Capacity 100 G.P.M.

WELL TESTS:

Drawdown 29 ft. after 100 hours 100 G.P.M.

Drawdown ft. after hours G.P.M.

USE OF WATER Irrigation.....Temp. °F., 19.....

SOURCE OF INFORMATION GR Record

DRILLER or DIGGER

ADDITIONAL DATA:

Log _____ Water Level Measurements _____ Chemical Analysis _____ Aquifer Test _____

REMARKS:

Log:	Clay	0 to 20 ft.
	Sand stone	20 to 500 ft.

Irrigation of 30 acres.