

STATE ENGINEER
Salem, Oregon

JAG
4013

Well Record

STATE WELL NO. 35/2W-28L
COUNTY Jackson
APPLICATION NO. GR-4029

OWNER: R. E. Carley

MAILING

ADDRESS:

CITY AND

STATE:

Central Point, Oregon

LOCATION OF WELL: Owner's No.

NE $\frac{1}{4}$ SW $\frac{1}{4}$ Sec. 28 T. 35 S. R. 2 W., W.M.


Bearing and distance from section or subdivision

corner 1600' N. & 100' W. from S $\frac{1}{4}$ Cor. Sec. 28

Altitude at well

TYPE OF WELL: Drilled Date Constructed 9/15/46

Depth drilled 82 ft. Depth cased

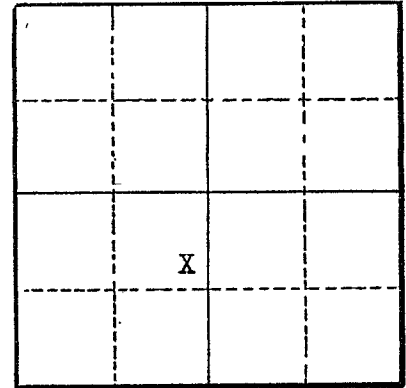

Section 28

CASING RECORD:

6 inch casing for 10 feet

FINISH:

AQUIFERS:

WATER LEVEL:

10 feet below surface

PUMPING EQUIPMENT: Type Berkeley H.P. 2
Capacity 40 G.P.M.

WELL TESTS:

Drawdown ft. after hours G.P.M.

Drawdown ft. after hours G.P.M.

USE OF WATER Domestic & Irrigation Temp. °F., 19

SOURCE OF INFORMATION Well Registration Statement Cert. # GR-3630

DRILLER or DIGGER Diester

ADDITIONAL DATA:

Log Water Level Measurements Chemical Analysis Aquifer Test

REMARKS: