

STATE ENGINEER
Salem, Oregon

JACK
4196

Well Record

STATE WELL NO. 35/2W- 31
COUNTY JACKSON
APPLICATION NO. GR-2735

OWNER: H. A. Davidson
MAILING ADDRESS: Rt. 2, Box 480
CITY AND STATE: Gold Hill, Oregon

LOCATION OF WELL: Owner's No.

NE $\frac{1}{4}$ NE $\frac{1}{4}$ NW $\frac{1}{4}$ Sec. 31 T. 35 S., R. 2 W., W.M.


Bearing and distance from section or subdivision

corner 34' S. and 530' W.

Altitude at well

TYPE OF WELL: dug Date Constructed 1954

Depth drilled 25 Depth cased 25

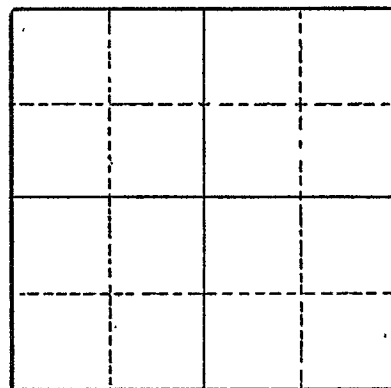

Section

CASING RECORD:

8.0-inch

FINISH:

15- $\frac{1}{2}$ " perforations per foot from 20 to 25

AQUIFERS:

WATER LEVEL:

9.0-feet

PUMPING EQUIPMENT: Type Berkeley Centrifugal H.P. 1.5
Capacity 40 G.P.M.

WELL TESTS:

Drawdown ft. after hours G.P.M.

Drawdown ft. after hours G.P.M.

USE OF WATER Supplemental irrigation Temp. °F. 19

SOURCE OF INFORMATION GR-2588

DRILLER or DIGGER

ADDITIONAL DATA:

Log Water Level Measurements Chemical Analysis Aquifer Test

REMARKS: