

STATE ENGINEER
Salem, Oregon

Well Record

4406 JACK

STATE WELL NO. 35/2W-36
COUNTY JACKSON
~~APPLICATION NO.~~ GR-2472

OWNER: R. W. and Stella Lewis

MAILING
ADDRESS: Rt. 2, Box 603


LOCATION OF WELL: Owner's No.

CITY AND
STATE: Central Point, Oregon

SW $\frac{1}{4}$ NW $\frac{1}{4}$ SE $\frac{1}{4}$ Sec. 36 T. 35 S. R. 2 W., W.M.

Bearing and distance from section or subdivision

corner 1390' N. and 2075' W.

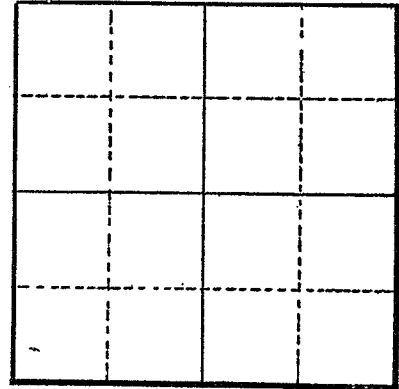

Section

Altitude at well

TYPE OF WELL: Dug Date Constructed 1947

Depth drilled 15 Depth cased

CASING RECORD:

FINISH:

AQUIFERS:

WATER LEVEL:

5.0-feet

PUMPING EQUIPMENT: Type Centrifugal pump H.P. 2.5
Capacity 50 G.P.M.

WELL TESTS:

Drawdown ft. after hours G.P.M.

Drawdown ft. after hours G.P.M.

USE OF WATER Irrigation Temp. °F. 19

SOURCE OF INFORMATION GR-2341

DRILLER or DIGGER By claimants

ADDITIONAL DATA:

Log Water Level Measurements Chemical Analysis Aquifer Test

REMARKS: