

STATE ENGINEER
Salem, Oregon

Jack
4766

Well Record


STATE WELL NO. 35/4W-4J
COUNTY JACKSON
APPLICATION NO. GR-2739

OWNER: William H. Johnston MAILING ADDRESS: Rt. 1, Box 171

LOCATION OF WELL: Owner's No. _____ CITY AND STATE: Rogue River, Oregon

NE 1/4 SE 1/4 Sec. 4 T. 35 N S., R. 4 E W., W.M.

Bearing and distance from section or subdivision corner 2493' N. and 754' W.

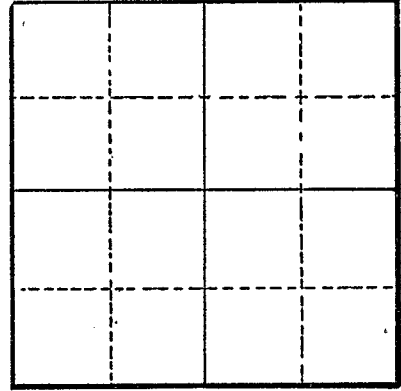

Section _____

Altitude at well _____

TYPE OF WELL: dug Date Constructed 1949

Depth drilled 10 Depth cased 10

CASING RECORD:

60-inch

FINISH:

AQUIFERS:

Loam, sandy and gravel

WATER LEVEL:

8-feet

PUMPING EQUIPMENT: Type Fairbanks Morse H.P. 3
Capacity 150 G.P.M.

WELL TESTS:

Drawdown _____ ft. after _____ hours _____ G.P.M.
Drawdown _____ ft. after _____ hours _____ G.P.M.

USE OF WATER irrigation Temp. _____ °F. _____, 19_____

SOURCE OF INFORMATION GR-2591

DRILLER or DIGGER _____

ADDITIONAL DATA:
Log Water Level Measurements _____ Chemical Analysis _____ Aquifer Test _____

REMARKS:

Loam & sandy 3
Gravel 7