

STATE ENGINEER
Salem, Oregon

JACK Well Record
5017

STATE WELL NO. 35/4W-11M(1)
COUNTY Jackson
APPLICATION NO. GR-598

OWNER: Jack J. Koop

MAILING ADDRESS:

Route 1, Box 69

LOCATION OF WELL: Owner's No.


CITY AND STATE:

Rogue River, Oregon

NW 1/4 SW 1/4 Sec. 11 T. 35 N. S. R. 4 E. W., W.M.

Bearing and distance from section or subdivision

corner 1060' S. & 380' E. from W 1/4 cor. Sec. 11

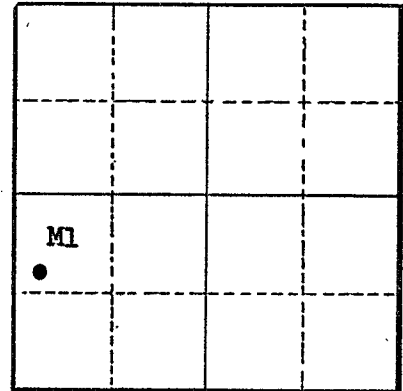

Section 11

Altitude at well 1154'

TYPE OF WELL: Dug Date Constructed May 1953

Depth drilled 9 Depth cased

CASING RECORD:

8' x 6' pit

FINISH:

AQUIFERS:

WATER LEVEL:

6'

PUMPING EQUIPMENT: Type Gould centrifugal

H.P. 3

Capacity 100 G.P.M.

WELL TESTS:

Drawdown 2 ft. after hours G.P.M.

Drawdown ft. after hours G.P.M.

USE OF WATER Irrigation 5 acres

Temp. °F. 19

SOURCE OF INFORMATION GR-598

DRILLER or DIGGER owner

ADDITIONAL DATA:

Log Water Level Measurements Chemical Analysis Aquifer Test

REMARKS: