

NOTICE TO WATER WELL CONTRACTOR

The original and first copy of this report are to be filed with the

JACK 50633

JACK 50633

JUN 2 1966 WATER WELL REPORT

STATE ENGINEER, SALEM, OREGON 97310 within 30 days from the date of well completion.

STATE OF OREGON (Please type or print) G-3656

State Well No. 38/1w-2J

State Permit No.

(1) OWNER:

Name Adamsville, Inc
Address Rt. 3 Box 231 Medford, Oregon

(2) LOCATION OF WELL:

County Jackson Driller's well number 47
Bearing and distance from section or subdivision corner Rest of W 1/4 200' North of Old stake # 81

Well # 1

(3) TYPE OF WORK (check):

Well [checked] Deepening [ ] Reconditioning [ ] Abandon [ ]

(4) PROPOSED USE (check):

Domestic [ ] Industrial [ ] Municipal [ ] Irrigation [ ] Test Well [ ] Other [ ]

(5) TYPE OF WELL:

Rotary [checked] Driven [ ] Cable [ ] Jetted [ ] Dug [ ] Bored [ ]

(6) CASING INSTALLED:

6" Diam. from 0 ft. to 21 ft. Gage 250

(7) PERFORATIONS:

Perforated? [ ] Yes [checked] No
Type of perforator used
Size of perforations in. by in.

(8) SCREENS:

Well screen installed? [ ] Yes [checked] No
Manufacturer's Name
Model No.

(9) CONSTRUCTION:

Well seal—Material used m seal Cement Grout
Depth of seal 18 ft. Was a packer used? NO
Diameter of well bore to bottom of seal 9 in.

(10) WATER LEVELS:

Static level 0 ft. below land surface Date 5-21-66
Artesian pressure lbs. per square inch Date

(11) WELL TESTS:

Drawdown is amount water level is lowered below static level.
Was a pump test made? [ ] Yes [checked] No
Yield: gal./min. with ft. drawdown after hrs.

(12) WELL LOG:

Diameter of well below casing 6
Depth drilled 120 ft. Depth of completed well 120 ft.

Formation: Describe by color, character, size of material and structure, and show thickness of aquifers and the kind and nature of the material in each stratum penetrated, with at least one entry for each change of formation.

Table with columns MATERIAL, FROM, TO. Entries: Brown sands fine 0 10, Blue sandstone 10 120, Water Bearing 95 105

Work started 5-21 1966 Completed 5-21 1966
Date well drilling machine moved off of well 5-21 1966

(13) PUMP:

Manufacturer's Name
Type: H.P.

Water Well Contractor's Certification:

This well was drilled under my jurisdiction and this report is true to the best of my knowledge and belief.

NAME Fred Robertson Well Drilling (Person, firm or corporation) (Type or print)

Address 14516 Dennis RD C.P.

Drilling Machine Operator's License No. 89

[Signed] Fred Robertson (Water Well Contractor)

Contractor's License No. 384 Date 5-21 1966



Oregon Water Resources Department
725 Summer Street NE, Suite A
Salem Oregon 97301
(503) 986-0900
www.oregon.gov/owrd

Application for
Well ID Number

RECEIVED

OCT 10 2019

OWRD

Do not complete if the well already has a Well Identification Number.

I. OWNER INFORMATION

Current Owner Name (please print): Fern Valley Estates Improvement District, (Well No.6)
Mailing Address: 2387 Terri Drive
City, State, Zip: Medford, OR 97504
Mail Well ID to: [ ] SAME AS ABOVE [X] In Care Of (C/O)
Name & Address: Harold L. Center, President FVEID
City, State, Zip: 2604 David Lane, Medford, OR 97504

II. WELL LOCATION INFORMATION (Please fill out as completely as possible)

Township: 38 South (North / South) Range: 1 West (East / West) Section: 2 SW 1/4 of the SE 1/4
Tax Lot (usually last 3-5 numbers of Tax Map #): 1300 County Jackson
GPS Coordinates: 42d 17' 29.39" N 122d 46' 46.15" W
Street Address of Well, City: 2675 David Lane, Medford, Or 97504
If the property had a different street address in the past: P.O. Box 982, Phoenix OR

III. GENERAL WELL INFORMATION (Please fill out as completely as possible, AND attach copy of Well Report, if available)

Use of Well (domestic, irrigation, commercial, industrial, monitoring): Domestic
Date Well Constructed (or property built): 05/21/1966 Total Well Depth: 105\* Casing Diameter: 6"
Owner at time the well was constructed (if known): Adamsville/FVEID Well Report # (if known): Jack 50633/14487
Other Information: \* well deepen to 200', see Jack 14487

SUBMITTED BY (please print): Harold L. Center, President FVEID
PHONE: 541-535-6108 EMAIL &/or FAX: center1071@gmail.com

Send application to: Oregon Water Resources Department 725 Summer St NE, Suite A, Salem, Oregon 97301; or fax to (503) 986-0902.
Applications are processed in the order they are received, and Well ID Numbers are mailed within 4-5 business days.

For Official Use Only by the Oregon Water Resources Department:
Received Date: 10-10-19
Well Report Number: JACK 50633 + JACK 14487
Well Identification #: L-135929
-ORIG- -DEEPEMED-


RECEIVED  
OCT 10 2019  
OWRD

FOR ASSESSMENT AND  
TAXATION ONLY

# JACK 50633

N.E. 1/4, S.E. 1/4, SEC. 2, T.38S., R. 1W., W.M.  
JACKSON COUNTY

38 1W 02DA

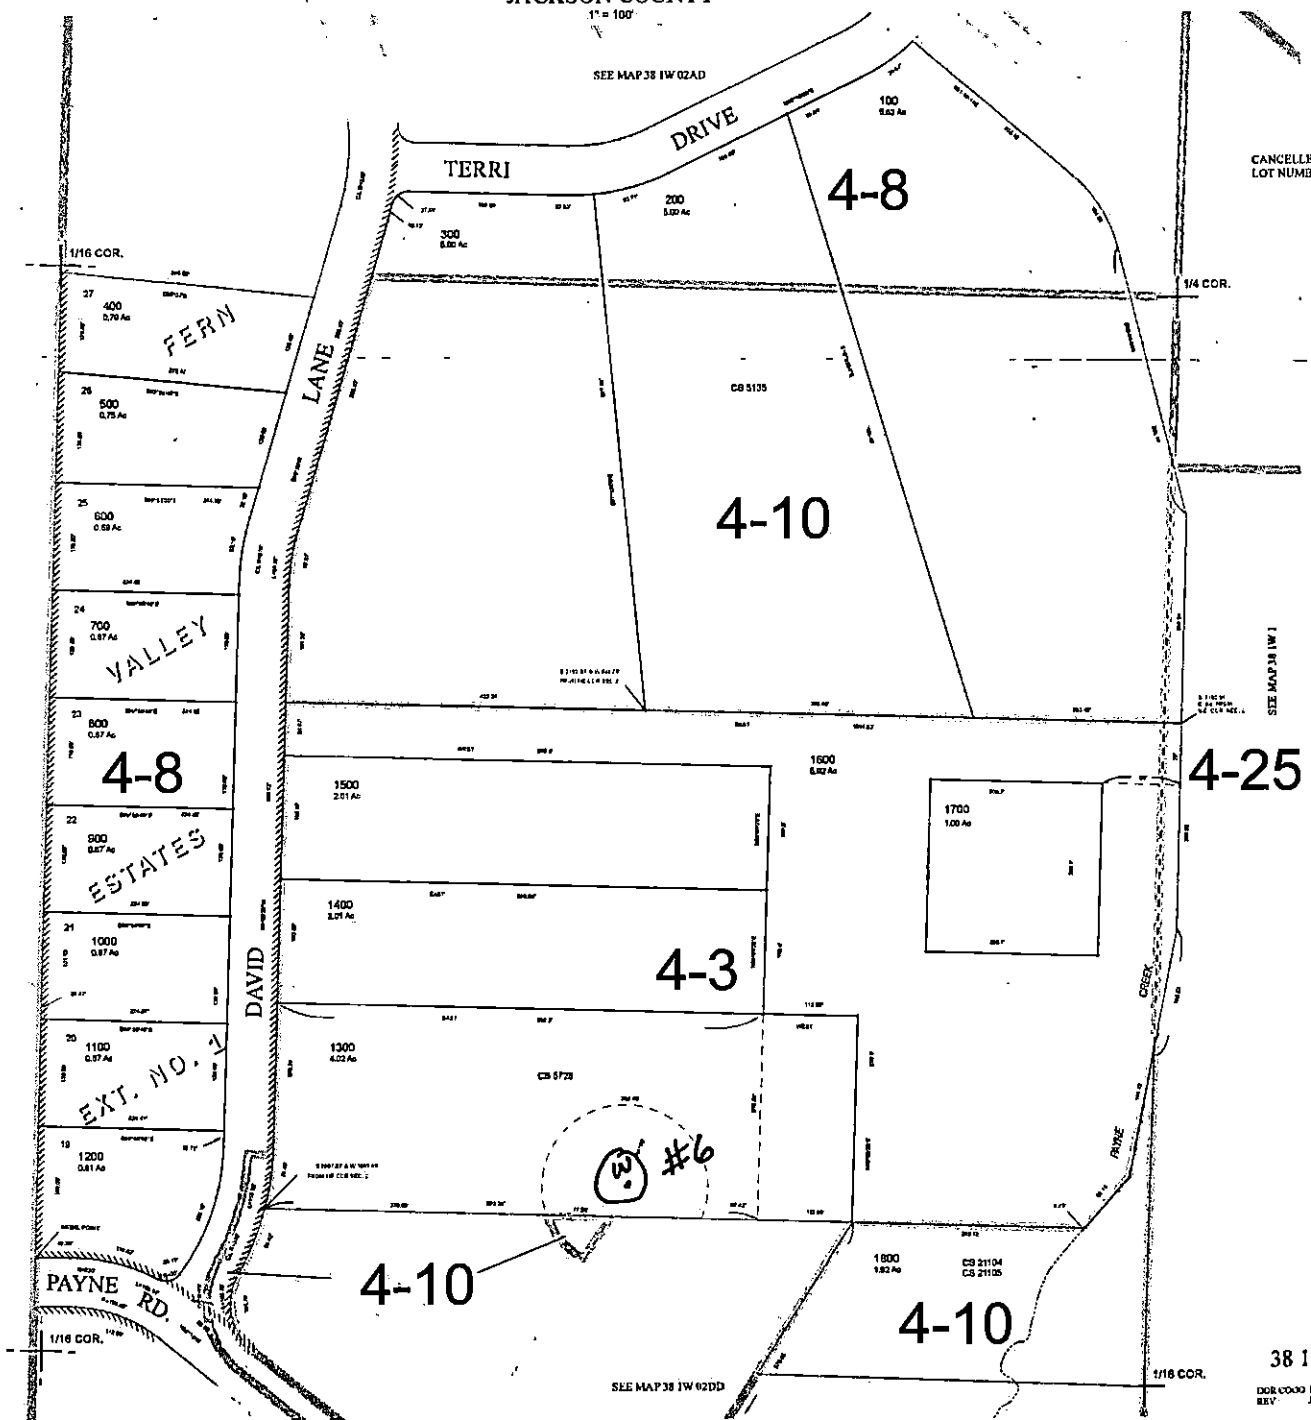

CANCELLED TAX  
LOT NUMBERS:

38 1W 02DA

DOR 0000 FEBRUARY 23, 2004  
REV. JULY 10, 2013

GIS DATA  
07/26/2010 08:52:11 AM - JAWHAWK