

STATE ENGINEER
Salem, Oregon

Jack
50637

JACK 50637
Well Record

GR- 1662

T385/R1W/5 Ba

STATE WELL NO. *38/1W-50*
COUNTY *Jackson*
APPLICATION NO. *GR-1713*

OWNER: *Harry & David, An Oregon Corp.*


MAILING ADDRESS: *P. O. Box 712*

LOCATION OF WELL: Owner's No.

CITY AND STATE: *Medford, Oregon*

NE 1/4 *NW* 1/4 Sec. *5* T. *38* S., R. *1* W., W.M.

Bearing and distance from section or subdivision
corner *2230' N. & 1450' E. from NE cor. DIC #47*

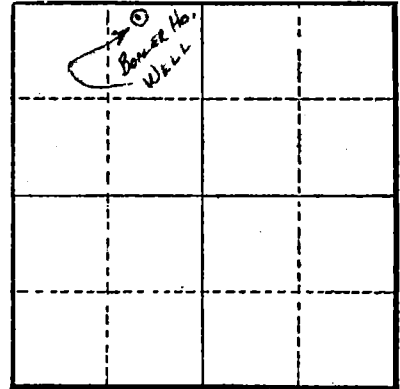

Section *5*

Altitude at well *1410'*

TYPE OF WELL: *Dug* Date Constructed *1948*

Depth drilled *16'* Depth cased *Sump*

CASING RECORD:

Sump- 25' x 2 to 3' x 16' - tiled

FINISH:

AQUIFERS:

WATER LEVEL:

12'

PUMPING EQUIPMENT: Type *Berkeley 1 1/2" (2) Cent.* H.P. *5*

Capacity *90* G.P.M.

WELL TESTS:

Drawdown *16* ft. after _____ hours *90* G.P.M.

Drawdown _____ ft. after _____ hours _____ G.P.M.

USE OF WATER *Manufacturing & Domestic* Temp. _____ °F., 19

SOURCE OF INFORMATION *GR Record*

DRILLER or DIGGER *Fred Sheffel*

ADDITIONAL DATA:

Log *N.A.* Water Level Measurements _____ Chemical Analysis _____ Aquifer Test _____

REMARKS: