

STATE ENGINEER
Salem, Oregon

Jack
5866

Well Record

STATE WELL NO. 36/1W-15K(1)
COUNTY Jackson
APPLICATION NO. GR- 1170

GR- 1131

OWNER: Dwane M. & Dorothy L. Lehman

MAILING

ADDRESS: Rt. 1, Box 89

LOCATION OF WELL: Owner's No.


CITY AND

STATE: Eagle Point, Oregon

NW ¼ SE ¼ Sec. 15 T. 36 S., R. 1 W., W.M.

Bearing and distance from section or subdivision

corner 245' S. & 1565' W. from E¼ cor. Sec. 15.

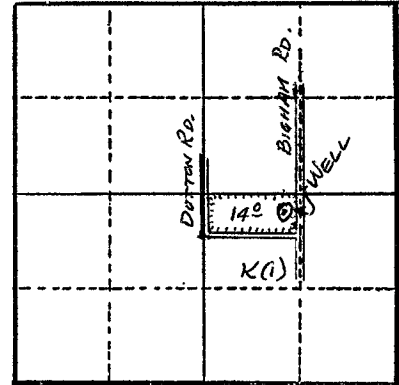

Section 15

Altitude at well 1380 ft.

TYPE OF WELL: Drilled Date Constructed 1955

Depth drilled 131 ft. Depth cased 30 ft.

CASING RECORD:

6 in. from 0 to 30 ft.

FINISH:

AQUIFERS:

WATER LEVEL:

20 ft.

PUMPING EQUIPMENT: Type 1½ submersible H.P. 2
Capacity 65 G.P.M.

WELL TESTS:

Drawdown _____ ft. after _____ hours _____ G.P.M.

Drawdown _____ ft. after _____ hours _____ G.P.M.

USE OF WATER Irrigation Temp. _____ °F. _____, 19

SOURCE OF INFORMATION G. R. Record

DRILLER or DIGGER Ray Diester

ADDITIONAL DATA:

Log N.A. Water Level Measurements _____ Chemical Analysis _____ Aquifer Test _____

REMARKS:

Irrigation of 14 acres.