

STATE OF OREGON
WATER SUPPLY WELL REPORT
 (as required by ORS 537.765 & OAR 690-205-0210)

WELL LABEL # L 100469
START CARD # 202925

(1) LAND OWNER Owner Well I.D. _____
 First Name Aaron Last Name Ward
 Company _____
 Address 1609 South 2230 East
 City Salt Lake City State UT Zip 84108

(2) TYPE OF WORK New Well Deepening Conversion
 Alteration (repair/recondition) Abandonment

(3) DRILL METHOD
 Rotary Air Rotary Mud Cable Auger Cable Mud
 Reverse Rotary Other _____

(4) PROPOSED USE Domestic Irrigation Community
 Industrial/ Commercial Livestock Dewatering
 Thermal Injection Other _____

(5) BORE HOLE CONSTRUCTION Special Standard (Attach copy)
 Depth of Completed Well 600 ft.
BORE HOLE

Dia	From	To	Material	SEAL From	To	Armt	sacks/ lbs
10	0	18	Bentonite Chips	0	18	8	S
6	18	600					

How was seal placed: Method A B C D E
 Other poured dry
 Backfill placed from _____ ft. to _____ ft. Material _____
 Filter pack from _____ ft. to _____ ft. Material _____ Size _____
 Explosives used: Yes Type _____ Amount _____

(6) CASING/LINER

Casing	Liner	Dia	From	To	Gauge	Stl	Plstc	Wld	Thrd
<input checked="" type="checkbox"/>	<input checked="" type="checkbox"/>	6	2	18	.250	<input checked="" type="checkbox"/>	<input checked="" type="checkbox"/>	<input checked="" type="checkbox"/>	<input checked="" type="checkbox"/>
<input type="checkbox"/>	<input type="checkbox"/>	4	5	600	160	<input type="checkbox"/>	<input type="checkbox"/>	<input type="checkbox"/>	<input type="checkbox"/>

Shoe Inside Outside Other Location of shoe(s) _____
 Temp casing Yes Dia _____ From _____ To _____

(7) PERFORATIONS/SCREENS

Perf/S	Casing/ Screen	Liner	Dia	From	To	Scr/slot width	Slot length	# of slots	Tele/ pipe size
Perf	Liner			540	600	.125	6	120	

(8) WELL TESTS: Minimum testing time is 1 hour

Pump Bailer Air Flowing Artesian

Yield gal/min	Drawdown	Drill stem/Pump depth	Duration (hr)
20	600	600	1

Temperature 57 °F Lab analysis Yes By _____
 Water quality concerns? Yes (describe below)

From	To	Description	Amount	Units

(9) LOCATION OF WELL (legal description)
 County JACKSON Twp 39 S N/S Range 2 W E/W WM
 Sec 8 1/4 of the _____ 1/4 Tax Lot 400
 Tax Map Number _____ Lot _____
 Lat _____ ° 0' _____ " or 42.18885 DMS or DD
 Long _____ ° 0' _____ " or -122.97185 DMS or DD
 Street address of well Nearest address
9090 Sterling Creek Road

(10) STATIC WATER LEVEL

Existing Well / Predeepening	Date	SWL(psi)	+ SWL(ft)
Completed Well	01-09-2010		42

Flowing Artesian? Dry Hole?

WATER BEARING ZONES Depth water was first found 406

SWL Date	From	To	Est Flow	SWL(psi)	+ SWL(ft)
01-09-2010	390	406	2		42
01-09-2010	517	600	18		42

(11) WELL LOG Ground Elevation _____

Material	From	To
clay with sand	0	4
weathered shale	4	9
granite-gray	9	184
granite with rhyolite ribs	184	390
granite-gray/green with qtz	390	406
granite-gray /green	406	517
granite-gray/green with qtz	517	600

RECEIVED
 JAN 19 2010
 WATER RESOURCES DEPT
 SALEM, OREGON


Date Started 01-09-2010 Completed 01-10-2010

(unbonded) Water Well Constructor Certification
 I certify that the work I performed on the construction, deepening, alteration, or abandonment of this well is in compliance with Oregon water supply well construction standards. Materials used and information reported above are true to the best of my knowledge and belief.
 License Number 1478 Date 01-14-2010
 Password: (if filing electronically) _____
 Signed _____

(bonded) Water Well Constructor Certification
 I accept responsibility for the construction, deepening, alteration, or abandonment work performed on this well during the construction dates reported above. All work performed during this time is in compliance with Oregon water supply well construction standards. This report is true to the best of my knowledge and belief.
 License Number 1478 Date 01-14-2010
 Password: (if filing electronically) _____
 Signed _____
 Contact Info (optional) _____

EXEMPT USE WELL LOCATION MAP

SEE MAP :

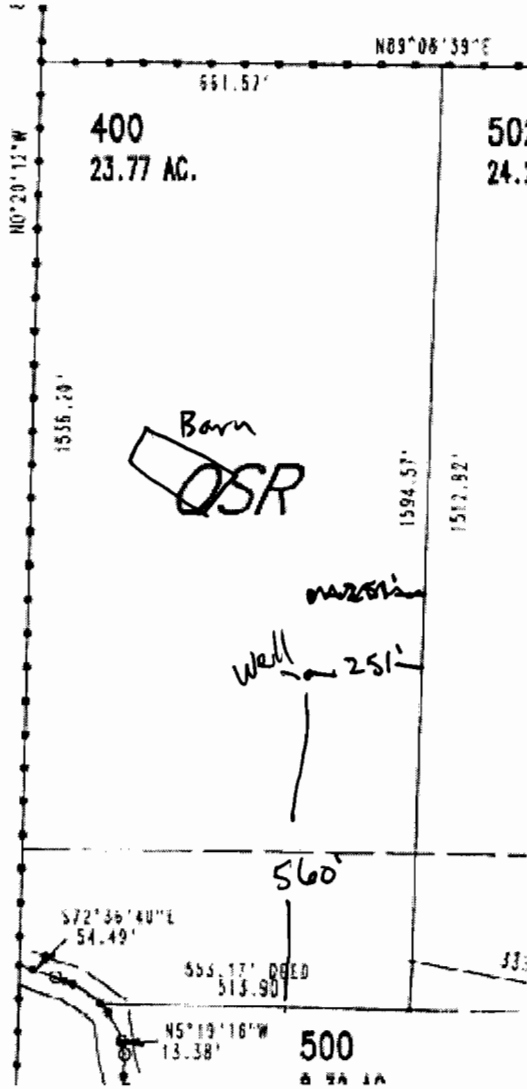

RECEIVED

FEB 10 2010

WATER RESOURCES DEPT
SALEM, OREGON



Jackson County

Assessor Map Reference Number: 39S 2W 8 NENE; Tax Lot 400

Street Address of Well, if Available: 9090 Sterling Creek Road, Jacksonville, OR

Well Log # JACK 59411, Well Label (ID Tag) # L 100469. (Please Locate Well and

Indicate distance From Property or Survey Corner, See Attached Sample Well Location

Map.) MAP NOT TO SCALE