

STATE ENGINEER  
Salem, Oregon

*Jack*  
*6047*

# Well Record


STATE WELL NO. 36/1W-20E(1)  
COUNTY Jackson  
APPLICATION NO. GR-264

OWNER: Olson Ross Lumber Co Inc. MAILING ADDRESS: .....

LOCATION OF WELL: Owner's No. #1 CITY AND STATE: Medford, Oregon

SW 1/4 NW 1/4 Sec. 20 T. 36 N. S. R. 1 E. W., W.M.

Bearing and distance from section or subdivision corner 1375' S. & 950' E. of NW cor. Sec. 20

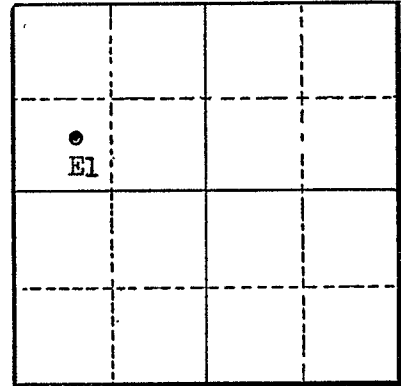

Section 20

Altitude at well 1325' Interpolated

TYPE OF WELL: Drilled Date Constructed 3/1/51

Depth drilled 80 Depth cased 80

### CASING RECORD:

6-inch casing set from 0 to 80 feet

### FINISH:

slots 6" x 1/2" set 6 to the foot from 0 to 30 feet

### AQUIFERS:

unknown

### WATER LEVEL:

20 feet below land surface 2/2/56

PUMPING EQUIPMENT: Type Fairbanks Morse H.P. 5  
Capacity 200 G.P.M.

### WELL TESTS:

Drawdown 10 ft. after ..... hours pumping 35 G.P.M.  
Drawdown 8 ft. after ..... hours " 30 G.P.M.

USE OF WATER Industrial 30 gpm Temp. ..... °F. ...., 19.....

SOURCE OF INFORMATION GR-264

DRILLER or DIGGER Goff Bros. Medford, Oregon

### ADDITIONAL DATA:

Log No Water Level Measurements ..... Chemical Analysis ..... Aquifer Test .....

### REMARKS: