



STATE OF OREGON
WATER SUPPLY WELL REPORT
(as required by ORS 537.765 & OAR 690-205-0210)

04-27-2011

WELL LABEL # L 46422

START CARD # 1013039

(1) LAND OWNER Owner Well I.D.

First Name Last Name
Company SUNRIDGE ESTATES HOMEOWNERS ASSOCIATION
Address 6556 HILLCREST RD.
City MEDFORD State OR Zip 97504

(2) TYPE OF WORK
New Well Deepening Conversion
Alteration (repair/recondition) Abandonment

(3) DRILL METHOD
Rotary Air Rotary Mud Cable Auger Cable Mud
Reverse Rotary Other

(4) PROPOSED USE
Domestic Irrigation Community
Industrial/ Commercial Livestock Dewatering
Thermal Injection Other

(5) BORE HOLE CONSTRUCTION Special Standard (Attach copy)

Table with columns: Dia, From, To, Material, SEAL, From, To, Amt, sacks/lbs. Includes rows for Bentonite Chips and Cement.

How was seal placed: Method A B C D E

Other POURED BEN. DRY
Backfill placed from ft. to ft. Material
Filter pack from ft. to ft. Material Size
Explosives used: Yes Type Amount

(6) CASING/LINER

Table with columns: Casing, Liner, Dia, From, To, Gauge, Stl, Plstc, Wld, Thrd. Includes rows for 6" and 5" diameters.

Shoe Inside Outside Other Location of shoe(s)
Temp casing Yes Dia From To

(7) PERFORATIONS/SCREENS

Table with columns: Perf/S, Casing/Screen, Dia, From, To, Scrm/slot width, Slot length, # of slots, Tele/pipe size. Includes rows for perforations and screens.

(8) WELL TESTS: Minimum testing time is 1 hour

Table with columns: Pump, Bailer, Air, Flowing Artesian, Yield gal/min, Drawdown, Drill stem/Pump depth, Duration (hr). Includes a row with values 1, 300, 1.

Table with columns: Temperature, Lab analysis, Water quality concerns, From, To, Description, Amount, Units. Includes a row with temperature 58.

(9) LOCATION OF WELL (legal description)

County Jackson Twp 37.00 S N/S Range 1.00 W E/W WM
Sec 25 SE 1/4 of the NE 1/4 Tax Lot 103
Tax Map Number Lot
Lat 0 0 or DMS or DD
Long 0 0 or DMS or DD
Street address of well Nearest address

6430 PINE RIDGE DRIVE. MEDFORD, OR

(10) STATIC WATER LEVEL

Table with columns: Date, SWL(psi), SWL(ft). Includes rows for Existing Well / Predeepening and Completed Well.

Flowing Artesian? Dry Hole?
WATER BEARING ZONES Depth water was first found

Table with columns: SWL Date, From, To, Est Flow, SWL(psi), SWL(ft).

(11) WELL LOG

Table with columns: Material, From, To, Ground Elevation. Includes rows for BASALT and UNKNOWN.

Date Started 04-19-2011 Completed 04-26-2011

(unbonded) Water Well Constructor Certification

I certify that the work I performed on the construction, deepening, alteration, or abandonment of this well is in compliance with Oregon water supply well construction standards. Materials used and information reported above are true to the best of my knowledge and belief.

License Number Date
Electronically Filed
Signed

(bonded) Water Well Constructor Certification

I accept responsibility for the construction, deepening, alteration, or abandonment work performed on this well during the construction dates reported above. All work performed during this time is in compliance with Oregon water supply well construction standards. This report is true to the best of my knowledge and belief.

License Number 1844 Date 04-27-2011
Electronically Filed
Signed COLTER CHANCELLOR (E-filed)
Contact Info (optional)

04-27-2011

START CARD # 1013039

(5) BORE HOLE CONSTRUCTION

BORE HOLE			SEAL		sacks/ lbs
Dia	From	To	Material	From To	

FILTER PACK

From	To	Material	Size

(6) CASING/LINER

Casing	Liner	Dia	+	From	To	Gauge	Stl	Plstc	Wld	Thrd

(7) PERFORATIONS/SCREENS

Perf/S creen	Casing/ Liner	Screen Dia	From	To	Scrn/slot width	Slot length	# of slots	Tele/ pipe size

(8) WELL TESTS: Minimum testing time is 1 hour

Yield gal/min	Drawdown	Drill stem/Pump depth	Duration (hr)

Water Quality Concerns

From	To	Description	Amount	Units

(10) STATIC WATER LEVEL

Water Bearing Zones

SWL Date	From	To	Est Flow	SWL(psi)	+ SWL(ft)

(11) WELL LOG

Material	From	To

Comments/Remarks

EXISTING WELL,
OVERDRILLED SEAL AND 6" CASING WITH 10" OVERREAMER.
INSTALLED NEW SEAL AND BRUSHED WELL.
AIR LIFTED TO CLEAN OUT RUST AND DEBRIS.
UNABLE TO TELL EXACT LOCATIONS OF PERFERATIONS WTH
DOWN HOLE CAMERA.
INSTALLED NEW 6" CASING FROM .5'- +1'

RECEIVED

JAN 28 2002

WATER RESOURCES DEPT SALEM, OREGON

WELL ID. # 416422

(1) LAND OWNER Well Number _____
 Name Laurel Crest Properties
 Address 6401 Hillcrest Rd
 City Medford State OR Zip 97504

(2) TYPE OF WORK
 New Well Deepening Alteration (repair/recondition) Abandonment

(3) DRILL METHOD:
 Rotary Air Rotary Mud Cable Auger
 Other _____

(4) PROPOSED USE:
 Domestic Community Industrial Irrigation
 Thermal Injection Livestock Other _____

(5) BORE HOLE CONSTRUCTION:
 Special Construction approval Yes No Depth of Completed Well 289 ft.
 Explosives used Yes No Type _____ Amount _____

HOLE		SEAL		Backs or pounds
Diameter	From To	Material	From To	
		Bent	0	Unknown

How was seal placed: Method A B C D E
 Other _____

Backfill placed from _____ ft. to _____ ft. Material _____
 Gravel placed from _____ ft. to _____ ft. Size of gravel _____

(6) CASING/LINER:

Diameter	From	To	Gauge	Steel	Plastic	Welded	Threaded
Casing: 6"	43	Unknown		<input checked="" type="checkbox"/>	<input type="checkbox"/>	<input type="checkbox"/>	<input type="checkbox"/>
Line: 5"	LS	Sediment		<input type="checkbox"/>	<input type="checkbox"/>	<input type="checkbox"/>	<input type="checkbox"/>

Drive Shoe used Inside Outside None
 Final location of shoe(s) _____

(7) PERFORATIONS/SCREENS:

Perforations Method _____
 Screens Type _____ Material _____

From	To	Slot size	Number	Diameter	Tube/pipe size	Casing	Liner
SEE DISCUSS							

(8) WELL TESTS: Minimum testing time is 1 hour
 Pump Baller Air Flowing Artesian
 Yield gallons _____ Drawdowns _____ Drift plan at _____ Time _____
 Unknown _____ _____ _____ 1 hr.

Temperature of water Unknown Depth Artesian Flow Found _____
 Was a water analysis done? Yes By whom _____
 Did any strata contain water not suitable for intended use? Too little
 Salty Muddy Other _____
 Depth of strata: _____

(9) LOCATION OF WELL by legal description:
 County Jackson Latitude _____ Longitude _____
 Township 37 N or S 1 E or W
 Section 25 NE 1/4 _____ 1/4
 Tax Lot 103 Lot 22 Block _____ Subdivision Spruce
 Street Address of Well (or nearest address) 6430 Pine Ridge Dr
 Medford OR 97504

(10) STATIC WATER LEVEL:
 84 ft. below land surface Date 8-22-00
 Artesian pressure _____ lb. per square inch Date _____

(11) WATER BEARING ZONES:
 Depth at which water was first found Unknown

From	To	Estimated Flow Rate	SWL
Unknown			

(12) WELL LOG:
 Ground Elevation _____

Material	From	To	SWL
Unknown			

Date started _____ Completed _____
 Approx. April 1990


SOURCE OF DATA/INFO
 Personal knowledge based on well inspection video on 8-22-00 and Jackson County Records

COMPILED BY: Michael J. McCall
 OWRO
 1-24-02

JUN 13 2012

60810

Well ID # 46402

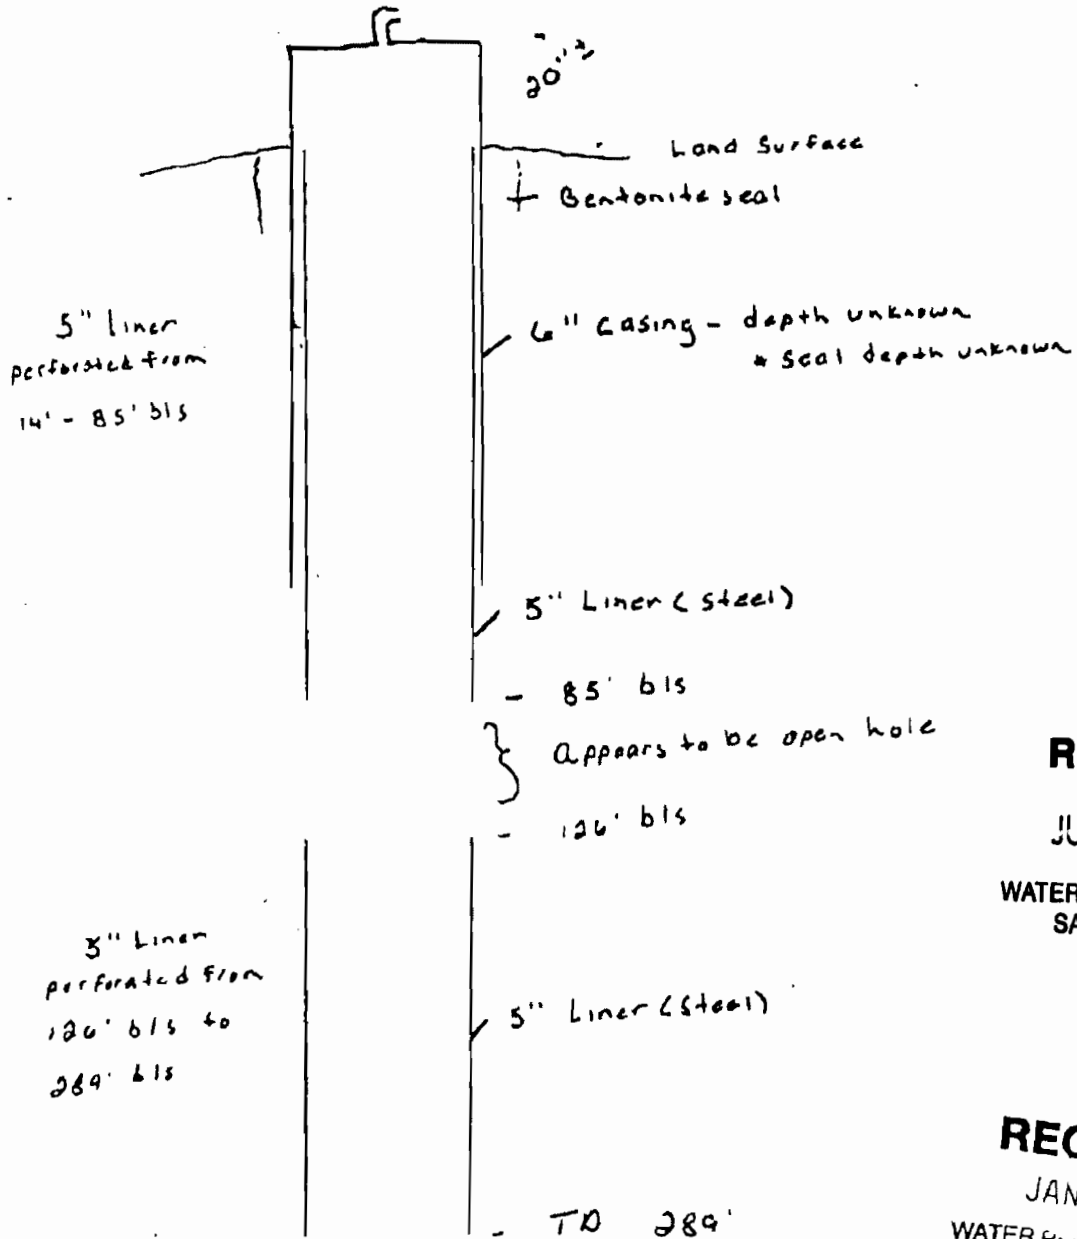

RECEIVED

JUN 13 2012

WATER RESOURCES DEPT
SALEM, OREGON

RECEIVED

JAN 28 2012

WATER RESOURCES DEPT
SALEM, OREGON

Not to scale